

15-179-05551-00-00

STATE OF KANSAS
STATE CORPORATION COMMISSION

Give All Information Completely
Make Required Affidavit
Mail or Deliver Report to:
Conservation Division
State Corporation Commission
211 No. Broadway
Wichita, Kansas

WELL PLUGGING RECORD

Sheridan County. Sec. 30 Twp. 7S Rge. 29 (E) (W) ^x

Location as "NE/CNW $\frac{1}{4}$ SW $\frac{1}{4}$ " or footage from lines SW SE SW

Lease Owner Empire Drilling Company

Lease Name Currey Well No. 2

Office Address 650 Fourth National Bank Building, Wichita, Kansas

Character of Well (completed as Oil, Gas or Dry Hole) Dry Hole

Date well completed January 15, 1960 19

Application for plugging filed January 15, 1960 19

Application for plugging approved January 15, 1960 19

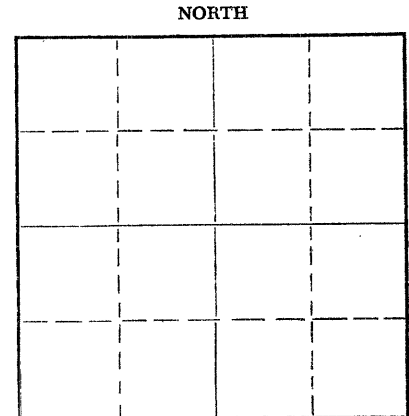
Plugging commenced January 15, 1960 19

Plugging completed January 15, 1960 19

Reason for abandonment of well or producing formation Dry Hole

If a producing well is abandoned, date of last production _____ 19

Was permission obtained from the Conservation Division or its agents before plugging was commenced? Yes



Locate well correctly on above Section Plat

Name of Conservation Agent who supervised plugging of this well A. D. Fabricius

Producing formation _____ Depth to top _____ Bottom _____ Total Depth of Well 4215 Feet

Show depth and thickness of all water, oil and gas formations.

OIL, GAS OR WATER RECORDS

CASING RECORD

FORMATION	CONTENT	FROM	TO	SIZE	PUT IN	PULLED OUT
	Shale-Sand	0	313	8 5/8"	298'	

Describe in detail the manner in which the well was plugged, indicating where the mud fluid was placed and the method or methods used in introducing it into the hole. If cement or other plugs were used, state the character of same and depth placed, from _____ feet to _____ feet for each plug set.

Plug set at 500' with 20 sacks cement
Plug set at 300' with 20 sacks cement
Plug set at 40' with 10 sacks cement

RECEIVED
STATE CORPORATION COMMISSION
01-25-1960
JAN 25 1960
CONSERVATION DIVISION

(If additional description is necessary, use BACK of this sheet)

Name of Plugging Contractor Empire Drilling Company
Address 650 Fourth National Bank Building, Wichita, Kansas

STATE OF KANSAS, COUNTY OF SEDGWICK, ss.
Dan J. Kornfeld (owner or operator) of the above-described

well, being first duly sworn on oath, says: That I have knowledge of the facts, statements, and matters herein contained and the log of the above-described well as filed and that the same are true and correct. So help me God.

(Signature) Dan J. Kornfeld
650-4th National Bank Bldg., Wichita, Kansas
(Address)

SUBSCRIBED AND SWORN TO before me this 21st day of January, 19 60

My commission expires October 21, 1962

Lucille H. Harr
Lucille H. Harr
Notary Public.



LOG

COMPANY: Empire Drilling Company
 CONTRACTOR: Empire Drilling Company
 FARM: Currey # 2
 LOCATION: SW SE SW of Section 30-7S-29W, Sheridan County, Kansas
 COMMENCED: January 6, 1960 ELEVATION: 2879 KB
 COMPLETED: January 15, 1960 POTENTIAL: D & A

0	to	313	Shale-Sand
313	to	1590	Shale-Shells
1590	to	2025	Shale-Sand-Shells
2025	to	2548	Shale-Shells
2548	to	2585	Anhydrite
2585	to	2640	Shale-Shells
2640	to	2835	Shale
2835	to	2955	Shale-Shells
2955	to	3200	Shale-Lime
3200	to	3415	Lime-Shale
3415	to	3475	Shale-Lime
3475	to	3540	Lime-Shale
3540	to	3640	Shale
3640	to	3765	Shale-Lime
3765	to	3880	Lime-Shale
3880	to	3955	Shale-Lime
3955	to	3995	Lime-Shale
3995	to	4045	Lime
4045	to	4100	KC Lime & Shale
4100	to	4215	Lime
4215			Rotary Total Depth

SET: 298' 8 5/8" casing with 150 sacks cement.

SAMPLE TOPS:

Anhydrite	2550	+ 329
Heebner	3946	-1068
Toronto	3973	-1094
Lansing	3985	-1106
Base Kansas City	4207	-1328

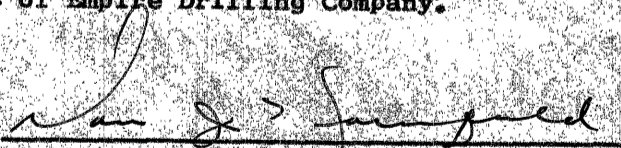
RECEIVED
STATE CORPORATION COMMISSION

JAN 25 1960

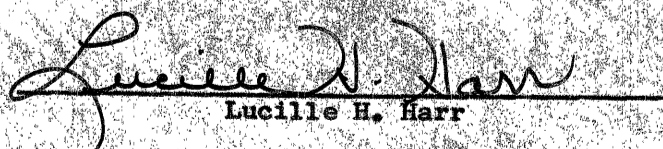
1/25/60

CERTIFICATION

I, Dan J. Kornfeld, do hereby certify that the above and foregoing is a true and correct copy of the log on the Currey # 2, SW SE SW of Section 30-7S-29W, Sheridan County, Kansas, as reflected by the files of Empire Drilling Company.


 Dan J. Kornfeld

SUBSCRIBED AND SWORN to before me, a Notary Public within and for Sedgwick County, Kansas, this 21st day of January, 1960.


 Lucille H. Harr

My commission expires October 21, 1962.