

STATE OF KANSAS
STATE CORPORATION COMMISSION

15-179-20459-00-00
WELL PLUGGING RECORD

Give All Information Completely
Make Required Affidavit
Mail or Deliver Report to
Conservation Division
State Corporation Comm.
245 North Water
Wichita, KS 67202

Sheridan County, Sec. 20 Twp. 7S Rge. 30 E/W
Location as "NE/CNW 1/4 SW 1/4" or footage from lines

NE NE


Lease Owner Gulf Energy & Minerals Company - U.S.
Lease Name Dale Gilchrist Well No. #1
Office Address 800 Three Twenty Four Bldg., Okla. City, Okla.
Character of Well (Completed as Oil, Gas or Dry Hole) Dry Hole

Date Well completed 6-7-77 19
Application for plugging filed 6-6-77 19
Application for plugging approved 6-6-77 19
Plugging commenced 6-6-77 19
Plugging completed 6-7-77 19

Reason for abandonment of well or producing formation
Commercial quantities of oil not found.
If a producing well is abandoned, date of last production 19

Was permission obtained from the Conservation Division or its agents before plugging was commenced? Yes

Name of Conservation Agent who supervised plugging of this well Gilbert Balthazor
Producing formation Depth to top Bottom Total Depth of Well 4680'
Show depth and thickness of all water, oil and gas formations.

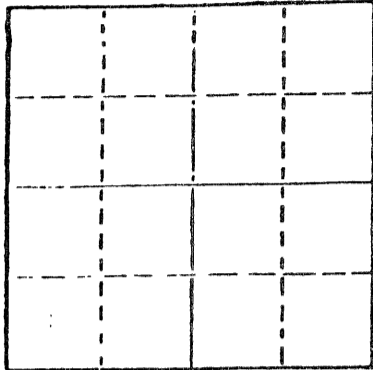

Locate well correctly on above Section Plat

OIL, GAS OR WATER RECORDS

CASING RECORD

FORMATION	CONTENT	FROM	TO	SIZE	PUT IN	PULLED OUT
				8 5/8"	414'	None
				Out off	6' below Ground level	

Describe in detail the manner in which the well was plugged, indicating where the mud fluid was placed and the method or methods used in introducing it into the hold. If cement or other plugs were used, state the character of same and depth placed, from feet to feet for each plug set.

Plug @ 1550' w/70 sx.
Plug @ 300' w/20 sx.
Plug @ 40' w/10 sx.
Rat Hole 2 sx.

RECEIVED
STATE CORPORATION COMMISSION
JUN 15 1977
06-15-1977
CONSERVATION DIVISION
Wichita, Kansas

(If additional description is necessary, use BACK of this sheet)

Name of Plugging Contractor Rains & Williamson Oil Co., Inc.

STATE OF Kansas COUNTY OF Sedgwick, ss.

Wilson Rains, President of Rains & Williamson Oil Co., Inc. (employee of owner) or (owner or operator) of the above-described well, being first duly sworn on oath, says: That I have knowledge of the facts, statements, and matters herein contained and the log of the above-described well as filed and that the same are true and correct. So help me God.


(Signature)

Wilson Rains
435 Page Court, 220 W. Douglas, Wichita, Ks. 67202
(Address)

SUBSCRIBED AND SWORN TO before me this 8 day of June, 19 77

My commission expires 10-4-79

Juanita M. Green
Notary Public.

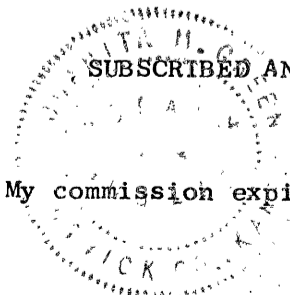

DRILLER'S LOG

15-179-20459-00-00

COMPANY: Gulf Energy & Minerals Company - U.S. SEC. 20 T. 7S R. 30W

LOC. NE NE

WELL NAME: Dale Gilchrist #1

COUNTY: Sheridan

RIG NO. #2

TOTAL DEPTH 4680'

ELEVATION

COMMENCED: 5-24-77

COMPLETED: 6-7-77

CONTRACTOR: Rains & Williamson Oil Co., Inc.

CASING RECORD:

SURFACE: 8 5/8" @ 414' w/100 sx. Class H, 16% gel, 2% cc., 3% salt and 100 sx. Class A, 3% cc., 2% gel.

PRODUCTION:

D & A

LOG

(Figures Indicate Bottom of Formations)

Sand	250
Shale	1953
Shale & Lime	2141
Shale	3090
Shale & Lime	4060
Lime	4680
<u>ROTARY TOTAL DEPTH</u>	<u>4680</u>

RECEIVED
STATE OCCUPATION COMMISSION

JUN 15 1977

6/15/77

CONSERVATION DIVISION
Wichita, Kansas

STATE OF Kansas)

COUNTY OF Sedgwick)

SS:

I, Wilson Rains, President of Rains & Williamson Oil Co., Inc.

upon oath state that the above and foregoing is a true and correct copy of the log of the

Dale Gilchrist #1 well.

Wilson Rains

Wilson Rains



Subscribed and sworn to before me this 8 day of June, 1977.

My Appointment Expires:

10-4-79

Juanita M. Green
Juanita M. Green