


Give All Information Completely  
Make Required Affidavit  
Mail or Deliver Report to:  
Conservation Division  
State Corporation Commission  
800 Bitting Building  
Wichita, Kansas

15-179-00052-00-00

WELL PLUGGING RECORD

NORTH

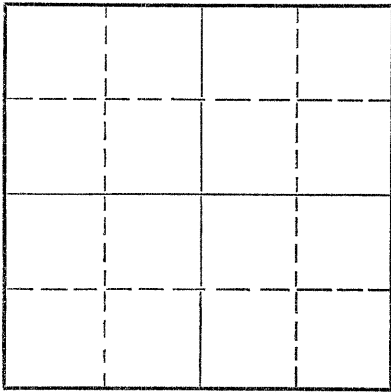

Locate well correctly on above  
Section Plat

Sheridan County, Sec. 22 Twp. 7 Rge. 30 (E) (W)  
Location as "NE/CNW/SW" or footage from lines \_\_\_\_\_  
Lease Owner W. W. Sauvage  
Lease Name Boggs Well No. 1  
Office Address Oberlin, Kansas  
Character of Well (completed as Oil, Gas or Dry Hole) dry hole  
Date well completed 3-20 19 54  
Application for plugging filed 3-20 19 54  
Application for plugging approved 3-20 19 54  
Plugging commenced 3-21 19 54  
Plugging completed 3-21 19 54  
Reason for abandonment of well or producing formation dry hole

If a producing well is abandoned, date of last production \_\_\_\_\_ 19 \_\_\_\_\_  
Was permission obtained from the Conservation Division or its agents before plugging was commenced? yes

Name of Conservation Agent who supervised plugging of this well M. A. Rives  
Producing formation \_\_\_\_\_ Depth to top \_\_\_\_\_ Bottom \_\_\_\_\_ Total Depth of Well 4660 Feet  
Show depth and thickness of all water, oil and gas formations.

OIL, GAS OR WATER RECORDS

CASING RECORD

FORMATION	CONTENT	FROM	TO	SIZE	PUT IN	PULLED OUT

Describe in detail the manner in which the well was plugged, indicating where the mud fluid was placed and the method or methods used in introducing it into the hole. If cement or other plugs were used, state the character of same and depth placed, from \_\_\_\_\_ feet to \_\_\_\_\_ feet for each plug set.

Filled hole with heavy mud on bottom pulled pipe and circulated with heavy mud. Set first plug 350 feet and 1/2 sx hulls mixed with 15 sx cement thru drill pipe and filled with mud to 40 feet with 1/2 sx hulls and 10 sx cement filled surface casing to bottom of cellar.

(If additional description is necessary, use BACK of this sheet)  
Name of Plugging Contractor Savage-Dunn Drilling Co., Inc. **03-27-1954**  
Address Oberlin, Kansas

STATE OF Kansas, COUNTY OF Decatur, ss.  
\_\_\_\_\_, (employee of owner) or (owner or operator) of the above-described well, being first duly sworn on oath, says: That I have knowledge of the facts, statements, and matters herein contained and the log of the above-described well as filed and that the same are true and correct. So help me God.

(Signature) Edmer Hoff  
(Address) \_\_\_\_\_

SUBSCRIBED AND SWORN TO before me this 23 rd day of March, 19 54

My commission expires May 17, 1955  
Opal Sauvage  
Notary Public.

PLUGGING  
MAR 22 1954  
PAGE 21 LINE 22

15-179-00052-00-00

DRILLERS LOG

OPERATOR: J. M. HICKMAN

Location: NE NE NE Sec. 22

FARM NAME: BOGGS

Twp. 7 Rge. 30

CONTRACTOR: SAUVAGE & DUNN DRIG. CO. INC.

Casing Record: 354 Ft.

ROTARY COMMENCED: 3-7-54

8 5/8 csg.

ROTARY COMPLETED: 3-20-54

ELEVATION: 2910

Cellar	5
Shale & Sand	354-1215
Shale & Shells	1215-1708
Shale & Sand	1708-2080
Shale & Shells	2080-2485
Shale	2485-2565
Top Anhyd.	2565-2645
Shale & Shells	2645-2825
Shale & Shells	2825-3080
Shale & Shells	3080-3230
Shale & Shells	3230-3350
Shale & Shells	3350-3422
Shale & Shells	3422-3515
Shale & Lime	3515-3700
Shale & Lime	3700-3962
Lime	3962-4015
Lime	4015-4175
Lime & Shale	4175-4274
Lime & Shale	4274-4317
Lime & Shale	4317-4457
Lime	4457-4537
Lime	4537-4600

CERTIFICATE

STATE OF KANSAS  
DECATUR COUNTY

I hereby certify that the foregoing is, to the best of my knowledge and belief a full, true and correct drilling as shown by the daily drilling reports in connection with the aforesaid well.

RCW 3/21/54

Edwin Hoff  
For Sauvage & Dunn Drilling Co. Inc.

Subscribed to and sworn to before me, the undersigned, a Notary Public, this 23rd day of March 1954.

Opal Sauvage  
Notary Public

My Commission expires May 17, 1955

PLUGGING  
Twp. 7 Rge. 30  
PAGE 21 LINE 22