


Give All Information Completely
Make Required Affidavit
Mail or Deliver Report to:
Conservation Division
State Corporation Commission
212 No. Market
Wichita, Kansas

WELL PLUGGING RECORD

NORTH

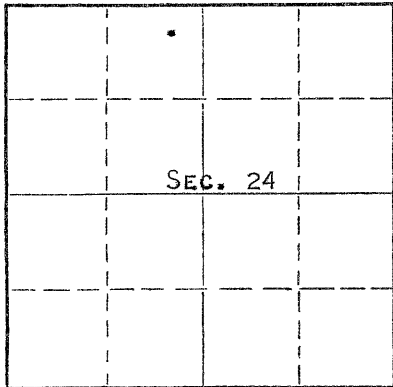

Locate well correctly on above Section Plat

SHERIDAN County. Sec. 24 Twp. 7s Rge. 30 (E)X (W)
Location as "NE/CNW%SW%" or footage from lines APP. NE NE NW
Lease Owner PETROLEUM, INC.,
Lease Name HUFFER Well No. 1
Office Address R.R. #2, GREAT BEND, KANSAS
Character of Well (completed as Oil, Gas or Dry Hole) DRY HOLE
Date well completed NOVEMBER 19 19 68
Application for plugging filed NOVEMBER 19 19 68
Application for plugging approved NOVEMBER 19 19 68
Plugging commenced NOVEMBER 19 19 68
Plugging completed NOVEMBER 19 19 68
Reason for abandonment of well or producing formation NO PRODUCIBLE ZONE

If a producing well is abandoned, date of last production NONE 19
Was permission obtained from the Conservation Division or its agents before plugging was commenced? YES

Name of Conservation Agent who supervised plugging of this well W. L. NICHOLS
Producing formation _____ Depth to top _____ Bottom _____ Total Depth of Well 4245 Feet
Show depth and thickness of all water, oil and gas formations.

OIL, GAS OR WATER RECORDS

CASING RECORD

FORMATION	CONTENT	FROM	TO	SIZE	PUT IN	PULLED OUT
				8-5/8"	312'	NONE

Describe in detail the manner in which the well was plugged, indicating where the mud fluid was placed and the method or methods used in introducing it into the hole. If cement or other plugs were used, state the character of same and depth placed, from _____ feet to _____ feet for each plug set.

HEAVY MUD TO 1650', FOLLOWED WITH 70 SACKS CEMENT. HEAVY MUD TO 310',
FOLLOWED WITH 20 SACKS CEMENT. HEAVY MUD TO 40', BRIDGE PLUG, FOLLOWED
WITH 10 SACKS CEMENT TO BASE OF WELL CELLAR.

RECEIVED
STATE CORPORATION COMMISSION
DEC 2 1968
CONSERVATION DIVISION
Wichita, Kansas

(If additional description is necessary, use BACK of this sheet)

Name of Plugging Contractor GARVEY DRILLING CO.
Address R.R. #2, GREAT BEND, KANSAS

STATE OF KANSAS, COUNTY OF BARTON, ss.
MONTE CHADD (employee of owner) or (owner or operator) of the above-described

well, being first duly sworn on oath, says: That I have knowledge of the facts, statements, and matters herein contained and the log of the above-described well as filed and that the same are true and correct. So help me God. MONTE CHADD, DIST. PROD. SUPT.

(Signature) Monte Chadd
R.R. #2, GREAT BEND, KANSAS
(Address)

SUBSCRIBED AND SWORN TO before me this 29 day of NOVEMBER, 19 68

WELL LOG

15-179-20161-00-00

COMPANY Petroleum, Inc.

SEC. 24 T. 7S R. 30W

FARM Huffer

NO. 1

LOC. NE NE NW


TOTAL DEPTH 4245'

COUNTY Sheridan Co., Kansas

COMM. 11-11-68

COMP. 11-19-68

CONTRACTOR Garvey Drilling Company

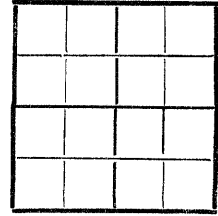

CASING 8 5/8" @ 312' w/225. sx

ELEVATION 2914' KB

PRODUCTION D & A

FIGURES INDICATE BOTTOM OF FORMATIONS

185' Surface Soil & Sand
 313' Sand
 1800' Shale & Shells
 1910' Shale
 2350' Sand
 2585' Shale
 2623' Anhydrite
 3310' Shale
 3677' Shale & Lime
 4090' Lime & Shale
 4245' Lime
 4245' RTD

RECEIVED
 STATE CORPORATION COMMISSION
 DEC 2 1968
 CONSERVATION DIVISION
 Wichita, Kansas

12/2/68

State of Kansas }
 County of Barton } ss

I, Eunice McEachern of Garvey Drilling Company

upon oath state the above and foregoing is a true and correct copy of the log of the Huffer No. 1 well.

Eunice McEachern

Subscribed and sworn to before me this 26th day of November 19 68

My Commission Expires: May 29th, 1969

Richard H. Dumbler
 NOTARY PUBLIC