

15-193-2011-00-00


STATE OF KANSAS  
STATE CORPORATION COMMISSION

WELL PLUGGING RECORD

API #15-193-20111

Give All Information Completely  
Make Required Affidavit  
Mail or Deliver Report to  
Conservation Division  
State Corporation Comm.  
245 North Water  
Wichita, KS 67202

Thomas County, Sec. 24 Twp. 7S Rge. 31 W  
Location as "NE/CNW $\frac{1}{4}$ SW $\frac{1}{4}$ " or footage from lines 660' FWL & 1980' FNL of Section 24.  
Lease Owner Gulf Oil Corporation  
Lease Name E. L. McCormick Well No. 4-24  
Office Address P.O. Box 12116, Oklahoma City, OK 73157  
Character of Well (Completed as Oil, Gas or Dry Hole) Dry Hole

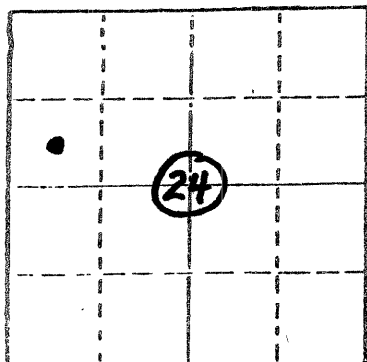

Locate well correctly on above Section Plot

Date Well completed January 26 1977  
Application for plugging filed November 3 1982  
Application for plugging approved November 12 1982  
Plugging commenced December 15 1982  
Plugging completed December 23 1982  
Reason for abandonment of well or producing formation Depleted

If a producing well is abandoned, date of last production 19

Was permission obtained from the Conservation Division or its agents before plugging was commenced? YES

Name of Conservation Agent who supervised plugging of this well Carl Woodrow  
Producing formation Lansing-KC Depth to top 4184 Bottom 4188 Total Depth of Well 4335  
Show depth and thickness of all water, oil and gas formations.

OIL, GAS OR WATER RECORDS

CASING RECORD

FORMATION	CONTENT	FROM	TO	SIZE	PUT IN	PULLED OUT
Lansing-Kansas City	oil-depleted	4184	4188	8-5/8"	471	NONE
				5-1/2"	4334	1700

Describe in detail the manner in which the well was plugged, indicating where the mud fluid was placed and the method or methods used in introducing it into the hold. If cement or other plugs were used, state the character of same and depth placed, from \_\_\_\_\_ feet to \_\_\_\_\_ feet for each plug set.

12/15-23/82: MIRU Barlow WS Unit. LD 4200' 2-3/8" OD tbg. MIRU Wellex. Run 5-1/2" CIBP. Set CIBP @ 4160'. RIH w/2-3/8" tbg to 4160'. MIRU Howco. Spot 10 sxs Class "H" cmt from 4160-4070'. POH w/tbg to 4070'. Pmp 37 bbls 9 ppg mud from 4070-2500'. POH w/tbg. RU csg pullers, shoot pipe @ 1700', pipe free. Spot 100 sxs 50/50 Pozmix w/6% gel 1700-1300'. Pull csg to 1300'. Pmp 50 bbls 9.2 ppg mud to 470'. Pull csg to 473'. Spot 150 sxs 50/50 Pozmix w/6% gal to sfc. POH w/csg. Carl Woodrow, State Man, on location. Filled well to 5' below ground level with cmt. Cut 8-5/8" csg off 5' below ground level. Capped and ID well. Clean up location. Well P&A'd 12-23-82.

(If additional description is necessary, use BACK of this sheet)

Name of Plugging Contractor Barlow Well Service - LICENSE #6690

STATE OF OKLAHOMA COUNTY OF OKLAHOMA, ss.  
Dorretta Moore (employee of owner) or (owner or operator)  
of the above-described well, being first duly sworn on oath, says: That I have knowledge of the facts, statements, and matters herein contained and the log of the above-described well as filed and that the same are true and correct. So help me God.

(Signature) Dorretta Moore  
(same as Operator shown above)

(Address) February, 1983.

SUBSCRIBED AND SWORN TO before me this 9th day of February, 1983.

Patricia A. Wonderly  
PATRICIA A. WONDERLY Notary Public.

My commission expires 01-31-87

RECEIVED  
STATE CORPORATION COMMISSION

FEB 10 1983  
02-10-1983  
CONSERVATION DIVISION  
Wichita Kansas