


15-179-20136-00-00

Form CP-4

STATE OF KANSAS
STATE CORPORATION COMMISSION
Give All Information Completely
Make Required Affidavit
Mail or Deliver Report to:
Conservation Division
State Corporation Commission
211 No. Broadway
Wichita, Kansas

WELL PLUGGING RECORD

NORTH

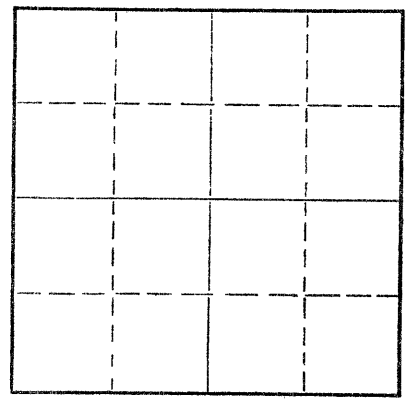

Locate well correctly on above
Section Plat

Sheridan County, Sec. 36 Twp. 7S Rge. (E) 30 (W)
Location as "NE/CNW/SW" or footage from lines 440' FNL 440' FWL
Lease Owner Braden Drilling, Inc. & Zenith Drilling Corp, Inc.
Lease Name Westerman Well No. 1-36
Office Address 1620 Wichita Plaza, Wichita, Kansas
Character of Well (completed as Oil, Gas or Dry Hole) D & A
Date well completed September 25 1968
Application for plugging filed September 25 1968
Application for plugging approved September 25 1968
Plugging commenced September 25 1968
Plugging completed September 25 1968
Reason for abandonment of well or producing formation D & A

If a producing well is abandoned, date of last production 19
Was permission obtained from the Conservation Division or its agents before plugging was commenced? yes

Name of Conservation Agent who supervised plugging of this well W. L. Nichols, Morland, Kansas
Producing formation _____ Depth to top _____ Bottom _____ Total Depth of Well 4261 Feet
Show depth and thickness of all water, oil and gas formations.

OIL, GAS OR WATER RECORDS

CASING RECORD

FORMATION	CONTENT	FROM	TO	SIZE	PUT IN	PULLED OUT
				8-5/8"	318.72	0

Describe in detail the manner in which the well was plugged, indicating where the mud fluid was placed and the method or methods used in introducing it into the hole. If cement or other plugs were used, state the character of same and depth placed, from _____ feet to _____ feet for each plug set.

Plugged with 153 Sacks Cement
Plug @ 1500' with 70 sacks
Plug @ 300' with 20 sacks 6% gel and Posmix
Plug @ 40 with bridge to hold Kelly with 10 sacks

RECEIVED
STATE CORPORATION COMMISSION
SEP 30 1968
CONSERVATION DIVISION
Wichita, Kansas
09-30-1968

(If additional description is necessary, use BACK of this sheet)
Name of Plugging Contractor Braden Drilling, Inc.
Address 1620 Wichita Plaza, Wichita, Kansas 67202

STATE OF Kansas, COUNTY OF Sedgwick, ss.
James Tasheff (employee of owner) or (owner or operator) of the above-described

well, being first duly sworn on oath, says: That I have knowledge of the facts, statements, and matters herein contained and the log of the above-described well as filed and that the same are true and correct. So help me God:

(Signature) James Tasheff
James Tasheff, Vice-President
1620 Wichita Plaza, Wichita, Kansas
(Address)

ESTHER LAMONE
NOTARY PUBLIC
SUBSCRIBED AND SWORN TO before me this 27th day of September, 1968
My Commission expires 1/19/69

Esther Lamone
Notary Public.