

15-193-30010-00-00
 WELL PLUGGING RECORD

Thomas County, Sec. 8 Twp. 7S Rge. (E) 31 (W)

Location as "NE/CNW/SW%" or footage from lines C. NW/4 SE/4

Lease Owner Target Drilling Corporation

Lease Name Dible No 1 Well No. 1

Office Address 910 Enterprise Bldg. Tulsa 3, Oklahoma

Character of Well (completed as Oil, Gas or Dry Hole) Dry Hole

Date well completed 3-28 1961

Application for plugging filed 3-28 1961

Application for plugging approved 3-28 1961


Plugging commenced 3-28- 1961

Plugging completed 3-28 1961

Reason for abandonment of well or producing formation No Productive horizons encountered.

If a producing well is abandoned, date of last production 19

Was permission obtained from the Conservation Division or its agents before plugging was commenced? Yes

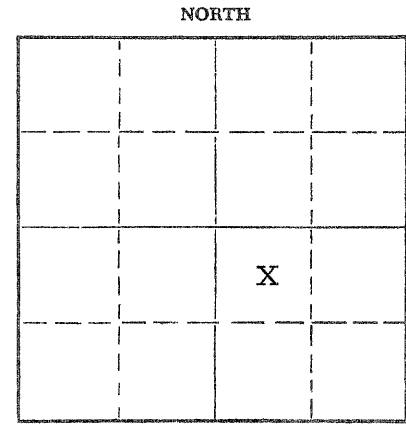

Locate well correctly on above Section Flat

Name of Conservation Agent who supervised plugging of this well Mr. Fabricus Hill City, Kansas

Producing formation None Depth to top X Bottom X Total Depth of Well 4700 Feet

Show depth and thickness of all water, oil and gas formations.

OIL, GAS OR WATER RECORDS

CASING RECORD

FORMATION	CONTENT	FROM	TO	SIZE	PUT IN	PULLED OUT
Water Sand	Fresh Water	190'	209'	8 5/8'	247'	None

Describe in detail the manner in which the well was plugged, indicating where the mud fluid was placed and the method or methods used in introducing it into the hole. If cement or other plugs were used, state the character of same and depth placed, from feet to feet for each plug set.

Set Cement plug at 400' with twenty sacks of cement, filled hole with Mud to 240' and set cement plug with twenty sacks cement, filled hole with Mud to 30' from surface, set plug with 10 sacks cement with two wires attached to plug and extending to surface.

RECEIVED
 STATE CORPORATION COMMISSION

APR 4 1961
 04-04-1961
 CONSERVATION DIVISION
 Wichita, Kansas

(If additional description is necessary, use BACK of this sheet)

Name of Plugging Contractor Halliburton Oil Well Cementing Co
 Address Atwood, Kansas

STATE OF Oklahoma, COUNTY OF Tulsa, ss.
 J. W. Genzer (employee of owner) or (owner or operator) of the above-described well, being first duly sworn on oath, says: That I have knowledge of the facts, statements, and matters herein contained and the log of the above-described well as filed and that the same are true and correct. So help me God.

(Signature) J. W. Genzer
 910 Enterprise Bldg., Tulsa, Oklahoma (Address)

SUBSCRIBED AND SWORN TO before me this 3rd day of April, 1961

My commission expires July 22, 1963
 November 13, 1963 John W. Caldwell Notary Public.



15-193-30010-00-00

TARGET DRILLING COMPANY #1 DIBLE
NW SE 8-7S-31W
THOMAS COUNTY, KANSAS

DRILLERS LOG

260-1355	Shale
1355-1995	Shale and lime
1995-2160	Shale and sand
2160-2284	Sand and shale
2284-2821	Shale and lime
2821-3060	Red beds
3060-3390	Shale and lime
3390-3723	Red beds and lime
3723-3960	Lime
3960-4038	Shale and lime
4038-4162	Lime
4162-4254	Lime and shale
4254-4568	Lime
4568-4617	Lime and shale
4617-4700	Lime

4/4/61

RECEIVED
APR 4 1961
CONSERVATION DIVISION
Wichita, Kansas

C. S. Cannan
C. S. Cannan

C. S. (STAN) CANNAN, CONSULTING GEOLOGIST, TULSA, OKLA.

State of Oklahoma)
County of Tulsa)

Subscribed and sworn to me a Notary Public this 31 st
day of March, 1961

Notary Public

My Commission expires _____