

15-193-20104-00-00


STATE OF KANSAS
STATE CORPORATION COMMISSION

WELL PLUGGING RECORD

Give All Information Completely
Make Required Affidavit
Mail or Deliver Report to
Conservation Division
State Corporation Comm.
245 North Water
Wichita, KS 67202

Thomas County, Sec. 13 Twp. 7S Rge. 31 ~~NE~~W
Location as "NE/CNW $\frac{1}{4}$ SW $\frac{1}{4}$ " or footage from lines
C NW SE

Lease Owner Gulf Energy & Minerals Company - U.S.
Lease Name McCormick Well No. #3-13
Office Address 324 N. Robinson, Okla. City, Okla.
Character of Well (Completed as Oil, Gas or Dry Hole)
Dry Hole

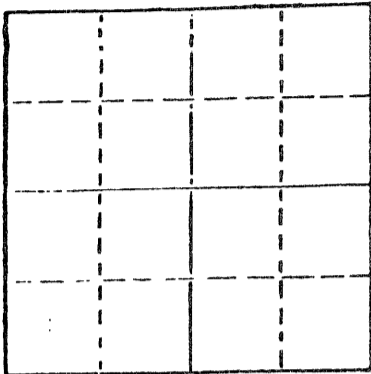

Locate well correctly on above
Section Plat

Date Well completed 12-29-76 19
Application for plugging filed 12-29-76 19
Application for plugging approved 12-29-76 19
Plugging commenced 12-29-76 19
Plugging completed 12-29-76 19
Reason for abandonment of well or producing formation
Commercial quantities of oil not found.
If a producing well is abandoned, date of last production 19

Was permission obtained from the Conservation Division or
its agents before plugging was commenced? Yes

Name of Conservation Agent who supervised plugging of this well Gilbert Balthazor, Palco, Ks
Producing formation _____ Depth to top _____ Bottom _____ Total Depth of Well 4300'
Show depth and thickness of all water, oil and gas formations.

OIL, GAS OR WATER RECORDS

CASING RECORD

FORMATION	CONTENT	FROM	TO	SIZE	PUT IN	PULLED OUT
				8 5/8"	470'	None

Describe in detail the manner in which the well was plugged, indicating where the mud fluid
was placed and the method or methods used in introducing it into the hold. If cement or other
plugs were used, state the character of same and depth placed, from _____ feet to
_____ feet for each plug set.

Plug @ 1550' w/70 sx.
Plug @ 300' w/20 sx. thru drill pipe
Plug @ 40' w/10 sx. thruu drill pipe

(If additional description is necessary, use BACK of this sheet)

Name of Plugging Contractor Rains & Williamson Oil Co., Inc. 01-24-1977

STATE OF Kansas COUNTY OF Sedgwick, ss.
Wilson Rains, President of Rains & Williamson Oil Co., Inc. (employee of owner) or (owner or operator)
of the above-described well, being first duly sworn on oath, says: That I have knowledge of
the facts, statements, and matters herein contained and the log of the above-described well
as filed and that the same are true and correct. So help me God.

(Signature) Wilson Rains
435 Page Court, 220 W. Douglas, Wichita, (Address)
Ks.

SUBSCRIBED AND SWORN TO before me this 3 day of January, 1977

My commission expires 10-4-79

Juanita M. Green
Juanita M. Green Notary Public.



15-193-20104-00-00
DRILLER'S LOG

YMK

COMPANY: Gulf Energy & Minerals Company - SEC. 13 T. 7S R. 31W
U.S. LOC. C NW SE
WELL NAME: McCormick #3-13 COUNTY: Thomas

RIG NO. #4

TOTAL DEPTH 4300' ELEVATION

COMMENCED: 12-16-76 COMPLETED: 12-29-76

CONTRACTOR: Rains & Williamson Oil Co., Inc.

CASING RECORD:

SURFACE: 8 5/8" @ 470' w/175 sx. 50/50 poz., 2% gel, 3% cc. and
100 sx. Class A, 3% cc.

PRODUCTION: D&A

LOG

(Figures Indicate Bottom of Formations)

Clay, Sand & Shale	300
Sand & Shale	480
Shale	625
Sand & Shale	1350
Shale & Shells	1370
Sand	1450
Shale	1680
Sand	1760
Shale	1860
Sand & Shale	2235
Shale	2305
Sand	2410
Redbed & Shale	2595
Shale & Redbed	2800
Redbed	2950
Shale & Redbed	3370
Redbed	3535
Shale & Lime	3685
Lime	3848
Lime & Shale	4020
Lime	4300
<u>ROTARY TOTAL DEPTH</u>	<u>4300</u>

1/21/77

STATE OF Kansas)
COUNTY OF Sedgwick) SS:

I, Wilson Rains, President of Rains & Williamson Oil Co., Inc.
upon oath state that the above and foregoing is a true and correct copy of the log of the
McCormick #3-13 well.

Wilson Rains
Wilson Rains

Subscribed and sworn to before me this 3 day of January, 1977.

My Appointment Expires:
10-4-79

Juanita M. Green
Juanita M. Green

