

15-193-20100-00-00


STATE OF KANSAS
STATE CORPORATION COMMISSION

WELL PLUGGING RECORD

Give All Information Completely
Make Required Affidavit
Mail or Deliver Report to
Conservation Division
State Corporation Comm.
245 North Water
Wichita, KS 67202

Thomas County, Sec. 13 Twp. 7S Rge. 31 E/W
Location as "NE/CNW 1/4 SW 1/4" or footage from lines

C SE SE
Lease Owner Gulf Energy & Minerals Company - U.S.
Lease Name McCormick Well No. #2-13
Office Address 324 N. Robinson, Okla. City, Okla.
Character of Well (Completed as Oil, Gas or Dry Hole)

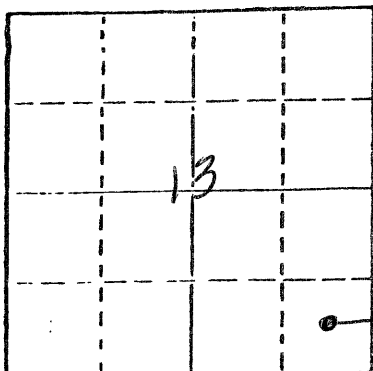

Locate well correctly on above
Section Plot

Dry Hole
Date Well completed 12-15-76 19
Application for plugging filed 12-15-76 19
Application for plugging approved 12-15-76 19
Plugging commenced 12-15-76 19
Plugging completed 12-15-76 19
Reason for abandonment of well or producing formation
Commercial quantities of oil not found.
If a producing well is abandoned, date of last production 19

Was permission obtained from the Conservation Division or its agents before plugging was commenced? Yes

Name of Conservation Agent who supervised plugging of this well Leo Massey, Hays, Kansas
Producing formation Depth to top Bottom Total Depth of Well 4285'
Show depth and thickness of all water, oil and gas formations.

OIL, GAS OR WATER RECORDS

CASING RECORD

FORMATION	CONTENT	FROM	TO	SIZE	PUT IN	PULLED OUT
				8 5/8"	434'	none

Describe in detail the manner in which the well was plugged, indicating where the mud fluid was placed and the method or methods used in introducing it into the hold. If cement or other plugs were used, state the character of same and depth placed, from feet to feet for each plug set.

Plug @ 1500' w/70 sx.
Plug @ 300' w/20 sx.
Plug @ 40' w/10 sx.

RECEIVED
STATE CORPORATION COMMISSION
DEC 29 1976
12-29-1976
CONSERVATION DIVISION
Wichita, Kansas

(If additional description is necessary, use BACK of this sheet)

Name of Plugging Contractor Rains & Williamson Oil Co., Inc.

STATE OF Kansas COUNTY OF Sedgwick, ss.
Wilson Rains, President of Rains & Williamson Oil Co., Inc. (employee of owner) or (owner or operator) of the above-described well, being first duly sworn on oath, says: that I have knowledge of the facts, statements, and matters herein contained and the log of the above-described well as filed and that the same are true and correct. So help me God.

(Signature) Wilson Rains
435 Page Court, 220 W. Douglas, Wichita, KS.
(Address)

SUBSCRIBED AND SWORN TO before me this 17 day of December, 19 76

Juanita M. Green
Notary Public.

My commission expires 10-4-79



DRILLER'S LOG

15-193-2000-00-00

COMPANY: Gulf Energy & Minerals Company - SEC. 13 T. 7S R. 31W
U.S. LOC. C SE SE
WELL NAME: McCormick #2-13 COUNTY: Thomas

RIG NO. #4

TOTAL DEPTH 4285' ELEVATION

COMMENCED: 12-6-76 COMPLETED: 12-15-76

CONTRACTOR: Rains & Williamson Oil Co., Inc.

CASING RECORD:

SURFACE: 8 5/8" @ 434' w/150 sx. 60/40 poz., 2% gel, 3% cc. and
100 sx. common, 3% cc.

PRODUCTION: D&A

LOG

(Figures Indicate Bottom of Formations)

Shale & Sand	165
Sand & Shale	440
Clay & Shale	1008
Shale & Sand	1560
Shale & Shells	1750
Sand	1800
Sand & Shale	2090
Shale	2114
Sand & Shale	2401
Sand	2430
Shale & Redbed	2460
Sand	2495
Redbed & Shale	2618
Shale & Redbed	2775
Redbed & Shale	3270
Shale & Redbed	3475
Redbed & Shale	3595
Shale & Lime	3856
Lime & Shale	3975
Lime	4285
<u>ROTARY TOTAL DEPTH</u>	<u>4285</u>

12/29/76

LOG 30.05

STATE OF Kansas)
COUNTY OF Sedgwick) SS:

I, Wilson Rains, President of Rains & Williamson Oil Co., Inc.
upon oath state that the above and foregoing is a true and correct copy of the log of the
McCormick #2-13 well.

Wilson Rains
Wilson Rains

Subscribed and sworn to before me this 17 day of December, 1976.

My Appointment Expires:
10-4-79

Juanita M. Green
Juanita M. Green

