


WELL PLUGGING RECORD

Give All Information Completely  
Make Required Affidavit  
Mail or Deliver Report to:  
Conservation Division  
State Corporation Commission  
800 Bitting Building  
Wichita, Kansas

NORTH

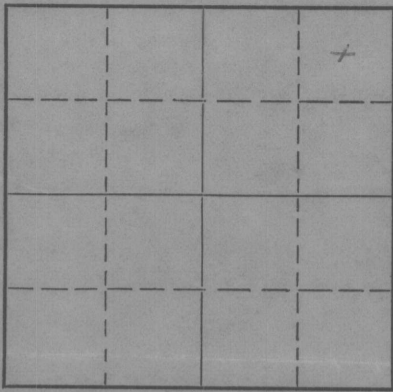

Locate well correctly on above  
Section Plat

Location as "NE/CNW $\frac{1}{4}$ /SW $\frac{1}{4}$ " or footage from lines  
Lease Owner Richard L. Felt & Co  
Lease Name Bennis Well No. 1  
Office Address 321 Centre St Dallas Texas  
Character of Well (completed as Oil, Gas or Dry Hole)  
Date well completed May 31 - 1958 19  
Application for plugging filed May 30 - 1958 19  
Application for plugging approved May 30 - 1958 19  
Plugging commenced 4:30 PM - May 31 - 1958 19  
Plugging completed 10:30 AM - May 31 - 1958 19  
Reason for abandonment of well or producing formation Dry

If a producing well is abandoned, date of last production 19  
Was permission obtained from the Conservation Division or its agents before plugging was commenced? Yes

Name of Conservation Agent who supervised plugging of this well J. H. D. Fabricius  
Producing formation Depth to top Bottom Total Depth of Well 4925 Feet  
Show depth and thickness of all water, oil and gas formations.

OIL, GAS OR WATER RECORDS

CASING RECORD

Formation	Content	From	To	Size	Put In	Pulled Out
<u>sand</u>	<u>water</u>	<u>110'</u>	<u>235'</u>	<u>8 7/8"</u>	<u>305'</u>	<u>no</u>

Describe in detail the manner in which the well was plugged, indicating where the mud fluid was placed and the method or methods used in introducing it into the hole. If cement or other plugs were used, state the character of same and depth placed, from feet to feet for each plug set.

Filled hole with mud to 550'  
#1 plug at 550' with 25 sacks cement thru drill pipe on plug -  
Filled hole to 300' with mud  
#2 plug at 300' with 15 sacks cement thru drill pipe on plug -  
Filled hole to 40' with mud  
#3 plug at 40' with 10 sack cement on plug  
filling hole to base of casing -

RECEIVED  
STATE CORPORATION COMMISSION  
JUN 6 1958  
06-06-1958  
CONSERVATION DIVISION  
Wichita, Kansas

(If additional description is necessary, use BACK of this sheet)

Correspondence regarding this well should be addressed to Richard L. Felt & Co  
Address 321 Centre Street Dallas, Texas

STATE OF Kansas, COUNTY OF Barton, SS. L. F. Hood (employee of owner) or (owner or operator) of the above-described well, being first duly sworn on oath, says: That I have knowledge of the facts, statements, and matters herein contained and the log of the above-described well as filed and that the same are true and correct. So help me God.

(Signature) L. F. Hood  
209 Penhook Lane Ellinwood, Kan (Address)

SUBSCRIBED AND SWORN TO before me this 4th day of June, 19 58

My commission expires October 22, 1960

Bernice Petz  
Bernice Petz Notary Public.

PLUGGING  
FILE SEC 14T 7 R 31W  
BOOK PAGE 105 LINE 2