

CARD MUST BE TYPED

State of Kansas

CARD MUST BE SIGNED

NOTICE OF INTENTION TO DRILL

(see rules on reverse side)

Starting Date ... Jan ... 14 ... 1986 ...
month day year

API Number 15— 059-24,132-00-00

OPERATOR: License # ... 9873 ...
Name ... Painter Oil Company, Inc ...
Address ... Route 2, Box 141-B ...
City/State/Zip ... Wellsville, KS 66092 ...
Contact Person ... Jerry Hardsaw ...
Phone ... 913.242.7310 ...

App. NW NE SW ... Sec. 21 ... Twp. ... 15S, Rg. ... 20 ... West
2475 ... Ft. from South Line of Section
3795 ... Ft. from East Line of Section

(Note: Locate well on Section Plat on reverse side)

CONTRACTOR: License # ... 6807 ...
Name ... Oil Drllrs & Dev., Inc ...
City/State ... 7939 SW 29th, Topeka, KS 66614 ...

Nearest lease or unit boundary line ... 165 ... feet
County ... Franklin

Lease Name ... Russell Leach ... Well # ... 14 ...
Ground surface elevation ... feet MSL

Well Drilled For: Well Class: Type Equipment:
X Oil SWD X Infield X Mud Rotary
Gas Inj Pool Ext Air Rotary
OWWO Expl Wildcat Cable

Domestic well within 330 feet: ___yes / X no
Municipal well within one mile: ___yes / X no
Surface pipe by Alternate: 1 ___ 2 X

If OWWO: old well info as follows:
Operator ...
Well Name ...
Comp Date ... Old Total Depth ...

Depth to bottom of fresh water ... 20 ...
Depth to bottom of usable water ... 200 ...
Surface pipe planned to be set ... 40 ...
Projected Total Depth ... 800 ... feet
Formation ... Squirrel

I certify that well will comply with K.S.A. 55-101, et seq., plus eventually plugging hole to KCC specifications.

... cementing will be done immediately upon setting production casing.

Date ... 1/13/86 ... Signature of Operator or Agent *Claine Jackson* ... Title ... as agent

For KCC Use:

Conductor Pipe Required ... feet; Minimum Surface Pipe Required ... 20 ... feet per Alt. X 2

This Authorization Expires ... 7-13-86 ... Approved By ... 1-13-86

Must be filed with the K.C.C. five (5) days prior to commencing well
This card void if drilling not started within six (6) months of date received by K.C.C.

1-13-86

RECEIVED
STATE CORPORATION COMMISSION


Important procedures to follow:

A Regular Section of Land
1 Mile = 5,280 Ft.

JAN 13 1986

CONSERVATION DIVISION

1. Notify District office before setting surface casing.
2. Set surface casing by circulating cement to the top.
3. File completion forms ACO-1 with K.C.C. within 90 days of well completion, following instructions on ACO-1, side 1, and including copies of wireline logs.
4. Notify District office 48 hours prior to old well workover or re-entry.
5. Prior to filing Intent, prepare a proposed plugging plan in case well is D & A, then obtain approval of plan when calling district office prior to setting surface pipe.
6. Submit plugging report (CP-4) to K.C.C. after plugging is completed.
7. Obtain an approved injection docket number before disposing of salt water.
8. Notify K.C.C. within 10 days when injection commences or terminates.
9. If an alternate 2 completion, cement in the production pipe from below any usable water to surface within 120 days of spud date.

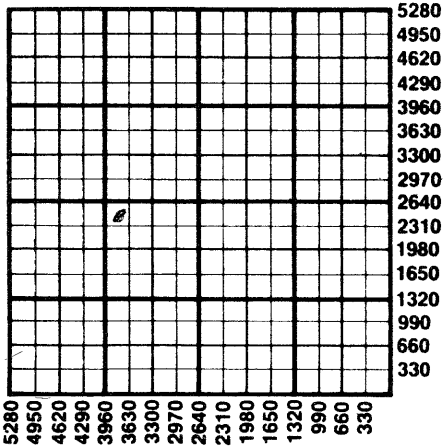

State Corporation Commission of Kansas
Conservation Division
200 Colorado Derby Building
Wichita, Kansas 67202
(316) 263-3238