

CARD MUST BE TYPED

State of Kansas

CARD MUST BE SIGNED

### NOTICE OF INTENTION TO DRILL

(see rules on reverse side)

Starting Date ..... Jan. 14 1986  
month day year

API Number 15— 059-24133-00-00

OPERATOR: License # 9873 App. NW NE SW  
Name Painter Oil Company, Inc.  
Address Route 2, Box 141-B  
City/State/Zip Wellsville, KS 66092  
Contact Person Jerry Hardsaw  
Phone 913 242 7310

Sec. 21 Twp. 15 S, Rg. 20 East  
2475 West  
3465 Ft. from South Line of Section  
Ft. from East Line of Section

(Note: Locate well on Section Plat on reverse side)

CONTRACTOR: License # 6807  
Name Oil Drllrs. & Dev., Inc.  
City/State 7939 SW 29th, Topeka, KS 66614

Nearest lease or unit boundary line 165 feet  
County Franklin  
Lease Name Russell Leach Well # 15

Well Drilled For: Well Class: Type Equipment:  
 Oil  SWD  Infield  Mud Rotary  
 Gas  Inj  Pool Ext.  Air Rotary  
 OWWO  Expl  Wildcat  Cable

Ground surface elevation ..... feet MSL  
Domestic well within 330 feet: \_\_\_yes  no  
Municipal well within one mile: \_\_\_yes  no  
Surface pipe by Alternate: 1 \_\_\_ 2    
Depth to bottom of fresh water ..... 20  
Depth to bottom of usable water ..... 200  
Surface pipe planned to be set ..... 40  
Projected Total Depth ..... 800 feet  
Formation ..... Squirrel

If OWWO: old well info as follows:  
Operator .....  
Well Name .....  
Comp Date ..... Old Total Depth.....

I certify that well will comply with K.S.A. 55-101, et seq., plus eventually plugging hole to KCC specifications.  
\_\_\_\_\_ cementing will be done immediately upon setting production casing.  
Date 1/13/86 Signature of Operator or Agent *Colanne D. Williams* Title \_\_\_\_\_ as agent

For KCC Use:  
Conductor Pipe Required ..... feet; Minimum Surface Pipe Required ..... 20 feet per Alt.  (2)  
This Authorization Expires 7-13-86 Approved By 1-13-86

Must be filed with the K.C.C. five (5) days prior to commencing well  
 This card void if drilling not started within six (6) months of date received by K.C.C.


1-13-86  
 RECEIVED  
 STATE CORPORATION COMMISSION

Important procedures to follow:

A Regular Section of Land  
 1 Mile = 5,280 Ft.

JAN 13 1986

CONSERVATION DIVISION

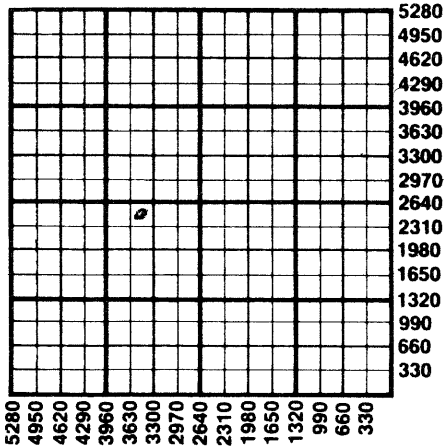

1. Notify District office before setting surface casing.
2. Set surface casing by circulating cement to the top.
3. File completion forms ACO-1 with K.C.C. within 90 days of well completion, following instructions on ACO-1, side 1, and including copies of wireline logs.
4. Notify District office 48 hours prior to old well workover or re-entry.
5. Prior to filing Intent, prepare a proposed plugging plan in case well is D & A, then obtain approval of plan when calling district office prior to setting surface pipe.
6. Submit plugging report (CP-4) to K. C. C. after plugging is completed.
7. Obtain an approved injection docket number before disposing of salt water.
8. Notify K.C.C. within 10 days when injection commences or terminates.
9. If an alternate 2 completion, cement in the production pipe from below any usable water to surface within 120 days of spud date.

State Corporation Commission of Kansas  
 Conservation Division  
 200 Colorado Derby Building  
 Wichita, Kansas 67202  
 (316) 263-3238