

CARD MUST BE TYPED

State of Kansas

CARD MUST BE SIGNED

NOTICE OF INTENTION TO DRILL

(see rules on reverse side)

Starting Date 12 month 21 day 1985 year

API Number 15— 059-24,120-00-00

OPERATOR: License # 9873 app. 3.75

SW NW SW Sec. 21 Twp. 15 S, Rg. 20 East

Name ... Painter Oil Company, Inc.

..... 1485 Ft. from South Line of Section

Address ... Rt. 2, Box 141-B 5115 Ft. from East Line of Section

City/State/Zip ... Wellsville, KS 66092

(Note: Locate well on Section Plat on reverse side)

Contact Person ... Jerry Hardsaw

Phone ... 913.242-7310

Nearest lease or unit boundary line ... 165 feet

CONTRACTOR: License # ~~6807~~ 6807

County ... Franklin

Name ... Oil Drls. & Dev. Inc.

Lease Name ... Russell Leach Well # 12

City/State ... 7939 S.W. 29th Topeka, KS 66614

Ground surface elevation ... na feet MSL

Well Drilled For: Well Class: Type Equipment:

Domestic well within 330 feet: ___yes no

Oil ___ SWD Infield Mud Rotary

Municipal well within one mile: ___yes no

___ Gas ___ Inj ___ Pool Ext. ___ Air Rotary

Surface pipe by Alternate: 1 ___ 2

___ OWWO ___ Expl ___ Wildcat ___ Cable

Depth to bottom of fresh water ... 20

If OWWO: old well info as follows:

Depth to bottom of usable water ... 200

Operator

Surface pipe planned to be set ... 40

Well Name

Projected Total Depth ... 800 feet

Comp Date Old Total Depth

Formation ... Squirrel

I certify that well will comply with K.S.A. 55-101, et seq., plus eventually plugging hole to KCC specifications.

Les/KCC

_____ cementing will be done immediately upon setting production casing.

Date ... 12/20/85 Signature of Operator or Agent *Shari Chalan* Title ... as agent

For KCC Use:

Conductor Pipe Required feet; Minimum Surface Pipe Required feet per AW 1 2

This Authorization Expires ... 6-20-86 Approved By ... 12-20-85 *LC*

Must be filed with the K.C.C. five (5) days prior to commencing well
 This card void if drilling not started within six (6) months of date received by K.C.C.

12-20-85


Important procedures to follow:

A Regular Section of Land
 1 Mile = 5,280 Ft.

RECEIVED
 STATE CORPORATION COMMISSION

DEC 20 1985

CONSERVATION DIVISION
 Wichita, Kansas

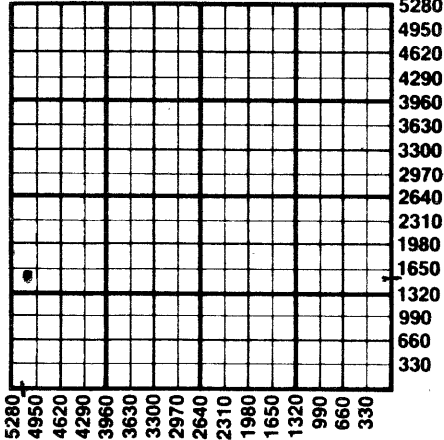

1. Notify District office before setting surface casing.
 Set surface casing by circulating cement to the top.
2. File completion forms ACO-1 with K.C.C. within 90 days of well completion, following instructions on ACO-1, side 1, and including copies of wireline logs.
3. Notify District office 48 hours prior to old well workover or re-entry.
4. Prior to filing Intent, prepare a proposed plugging plan in case well is D & A, then obtain approval of plan when calling district office prior to setting surface pipe.
5. Submit plugging report (CP-4) to K. C. C. after plugging is completed.
6. Obtain an approved injection docket number before disposing of salt water.
7. Notify K.C.C. within 10 days when injection commences or terminates.
8. If an alternate 2 completion, cement in the production pipe from below any usable water to surface within 120 days of spud date.

State Corporation Commission of Kansas
 Conservation Division
 200 Colorado Derby Building
 Wichita, Kansas 67202
 (316) 263-3235