

CARD MUST BE TYPED

State of Kansas

CARD MUST BE SIGNED

NOTICE OF INTENTION TO DRILL

(see rules on reverse side)

Starting Date 12 month 21 day 1985 year *3:15*

API Number 15— *059-24121-00-00*

OPERATOR: License # *9873*
Name *Painter Oil Company Inc.*
Address *Rt. 2, Box 141-B*
City/State/Zip *Wellsville, KS 66092*
Contact Person *6804*
Phone *913 242-7310*

app. NW SW SW Sec. *21* Twp. *15* S, Rg. *20* East
_____ West
_____ 1155 Ft. from South Line of Section
_____ 5115 Ft. from East Line of Section

(Note: Locate well on Section Plat on reverse side)

CONTRACTOR: License # ~~5804~~ *6807*
Name *Oil Drls. & Dev. Inc.*
City/State *7939 S.W. 29th Topeka, KS 66614*

Nearest lease or unit boundary line *165* feet
County *Franklin*
Lease Name *Russell Leach* Well # *13*

Well Drilled For: Well Class: Type Equipment:
 Oil SWD Infield Mud Rotary
 Gas Inj Pool Ext. Air Rotary
 OWWO Expl Wildcat Cable

Ground surface elevation *na* feet MSL
Domestic well within 330 feet: _____ yes no
Municipal well within one mile: _____ yes no
Surface pipe by Alternate: 1 _____ 2 _____
Depth to bottom of fresh water *20*
Depth to bottom of usable water *200*
Surface pipe planned to be set *40*
Projected Total Depth *800* feet
Formation *Squirrel*

If OWWO: old well info as follows:

Operator
Well Name
Comp Date Old Total Depth

I certify that well will comply with K.S.A. 55-101, et seq., plus eventually plugging hole to KCC specifications.

~~_____~~ cementing will be done immediately upon setting production casing.

Date *12/20/85* Signature of Operator or Agent *Sherril Cholar* Title *as agent*

For KCC Use:

Conductor Pipe Required feet; Minimum Surface Pipe Required feet per Alt. *1 2*

This Authorization Expires *6-20-86* Approved By *12-20-85 RC*

RC/KCC

Must be filed with the K.C.C. five (5) days prior to commencing well
This card void if drilling not started within six (6) months of date received by K.C.C.

12-20-89


Important procedures to follow:

RECEIVED
STATE CORPORATION COMMISSION

A Regular Section of Land
1 Mile = 5,280 Ft.

DEC 20 1985

CONSERVATION DIVISION
Wichita, Kansas

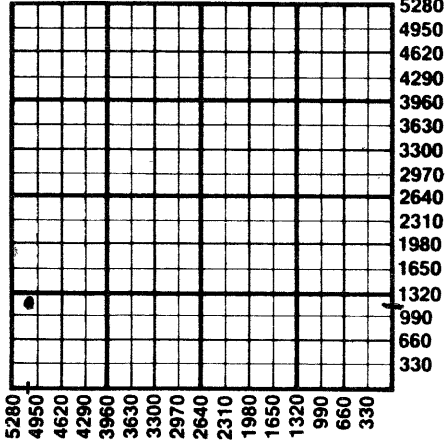

1. Notify District office before setting surface casing.
2. Set surface casing by circulating cement to the top.
3. File completion forms ACO-1 with K.C.C. within 90 days of well completion, following instructions on ACO-1, side 1, and including copies of wireline logs.
4. Notify District office 48 hours prior to old well workover or re-entry.
5. Prior to filing Intent, prepare a proposed plugging plan in case well is D & A, then obtain approval of plan when calling district office prior to setting surface pipe.
6. Submit plugging report (CP-4) to K. C. C. after plugging is completed.
7. Obtain an approved injection docket number before disposing of salt water.
8. Notify K.C.C. within 10 days when injection commences or terminates.
9. If an alternate 2 completion, cement in the production pipe from below any usable water to surface within 120 days of spud date.

State Corporation Commission of Kansas
Conservation Division
200 Colorado Derby Building
Wichita, Kansas 67202
(316) 263-3238