

CARD MUST BE TYPED

State of Kansas

CARD MUST BE SIGNED

NOTICE OF INTENTION TO DRILL

(see rules on reverse side)

Expected Spud Date. 01/02/89
month day year

API Number 15- 059-24,404-00-00

OPERATOR: License # 6807
Name OIL DRILLERS & DEVELOPERS, Inc.
Address 901 GARFIELD
City/State/Zip TOPEKA, KANSAS 16614
Contact Person JERRY FEAGAN
Phone (913) 354-9591

SE SE SE Sec. 22 Twp. 15 S, Rg. 20 XX East
330 Ft. from South Line of Section
330 Ft. from East Line of Section

(Note: Locate well on Section Plat on reverse side)

CONTRACTOR: License # 3417
Name SIMPSON DRILLING
City/State OSAWATOMIE, KANSAS 66064

Nearest lease or unit boundary line 330 feet
County FRANKLIN
Lease Name AURTHUR MADL Well # 1-89
Ground surface elevation APX 1000 feet MSL

Well Drilled For: Well Class: Type Equipment:
XX Oil XX Infield XX Mud Rotary
XX Gas — Pool Ext. — Air Rotary
— OWWO — Expl — Wildcat — Cable

Domestic well within 330 feet: — yes XX no
Municipal well within one mile: — yes XX no
Depth to bottom of fresh water 165
Depth to bottom of usable water 175 200'

If OWWO: old well info as follows:
Operator
Well Name
Comp Date Old Total Depth

Surface pipe by Alternate: 1 XX
Surface pipe planned to be set 40
Conductor pipe required *****
Projected Total Depth 900 feet
Formation BARTLESVILLE SAND

I certify that well will comply with K.S.A. 55-101, et seq., plus eventually plugging hole to KCC specifications.
Date 12/23/88 Signature of Operator or Agent Jerry Feagan Title AGENT

For KCC Use:
Conductor Pipe Required _____ feet; Minimum Surface Pipe Required _____ feet per Alt. 20'
This Authorization Expires 6-23-89 Approved By L.K.M. 12-23-88

EFFECTIVE DATE: 12-28-88


2

Must be filed with the K.C.C. five (5) days prior to commencing well
 This card void if drilling not started within six (6) months of date received by K.C.C.

Important procedures to follow:

1. Notify District office before setting surface casing.
2. Set surface casing by circulating cement to the top.
3. File completion forms ACO-1 with K.C.C. within 120 days of well spud date, following instructions on ACO-1, side 1, and including copies of wireline logs.
4. Notify District office 48 hours prior to old well workover or re-entry.
5. Prior to filing Intent, prepare a proposed plugging plan in case well is D & A, then obtain approval of plan when calling district office prior to setting surface pipe.
6. Submit plugging report (CP-4) to K.C.C. after plugging is completed.
7. Obtain an approved injection docket number before disposing of salt water.
8. Notify K.C.C. within 10 days when injection commences or terminates.

A Regular Section of Land
1 Mile = 5,280 Ft.

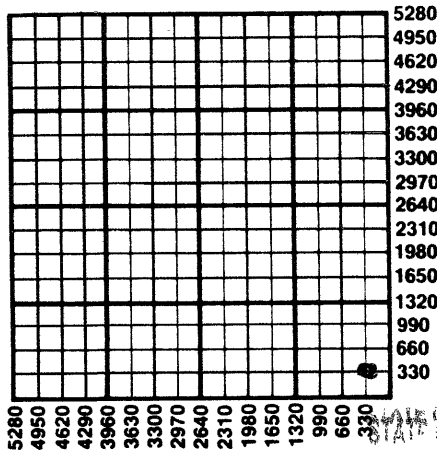

RECEIVED
 STATE CORPORATION COMMISSION
 STATE CORPORATION

9. If an alternate 2 completion, cement in the production pipe from below any usable water to surface within 120 days of spud date.

DEC 25 1988

CONSERVATION DIVISION
 Wichita, Kansas

12-23-88

State Corporation Commission of Kansas
 Conservation Division
 200 Colorado Derby Building
 Wichita, Kansas 67202-1212
 (316) 263-3238