

CARD MUST BE TYPED

State of Kansas
NOTICE OF INTENTION TO DRILL
(see rules on reverse side)

7-16
CARD MUST BE SIGNED

Starting Date: August 4, 1984
month day year

API Number 15- 059-23,613-00-00

OPERATOR: License # 8389
Name Greenwood Resources Inc.
Address 315 Inverness Way South
City/State/Zip Englewood, CO 80112
Contact Person Poul E. Poulsen
Phone (303) 790-1266

NE SE NE Sec 23 Twp 15 S, Rge 21
(location) 20
39.55 Ft North from Southeast Corner of Section
16.5 Ft West from Southeast Corner of Section
(Note: Locate well on Section Plat on reverse side)

CONTRACTOR: License # 5666
Name Finch Drilling Company
City/State Ottawa, KS

THIS PERMIT
JAN 17 1985
EXPIRES

Nearest lease or unit boundary line 16.5 feet.
County Franklin
Lease Name Broersa, Joe Well# 17-E
Domestic well within 330 feet: yes no
Municipal well within one mile: yes no

Well Drilled For: Well Class: Type Equipment:
 Oil Swd Infield Mud Rotary
 Gas Inj Pool Ext. Air Rotary
 OWWO Expl Wildcat Cable

Depth to Bottom of fresh water 0 feet
Lowest usable water formation Lansing Group
Depth to Bottom of usable water 200 feet
Surface pipe by Alternate: 1 2
Surface pipe to be set 20 feet
Conductor pipe if any required N/A feet
Ground surface elevation feet MSL
This Authorization Expires Jan 16, 1985
Approved By RCH/KAC 7-16-84

If OWWO: old well info as follows:

Operator
Well Name
Comp Date Old Total Depth
Projected Total Depth 900 feet
Projected Formation at TD Squirrel Sand
Expected Producing Formations Squirrel Sand


I certify that we will comply with K.S.A. 55-101, et seq., plus eventually plugging hole to K.C.C. specifications.

Date 7-13-84 Signature of Operator or Agent Poul E. Poulsen Title V.P. Engineering
MHC/KOHE 7-17-84 Form C-1 4/84

Must be filed with the K.C.C. five (5) days prior to commencing well
 This card void if drilling not started within six (6) months of date received by K.C.C.

Important procedures to follow :

**A Regular Section of Land
 1 Mile = 5,280 Ft.**

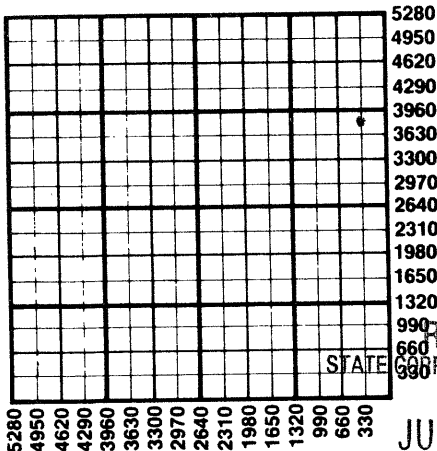

1. Notify District office before setting surface casing.
 2. Set surface casing by circulating cement to the top.
 3. File completion forms ACO-1 with K.C.C. within 90 days of well completion, following instructions on ACO-1, side 1, and including copies of wireline logs.
 4. Notify District office 48 hours prior to old well workover or re-entry.
 5. Prior to plugging, prepare a plugging plan, then obtain agreement from the appropriate district office for an approved plugging plan.
 6. Submit plugging report (CP-4) to K.C.C. after plugging is completed.
 7. Obtain an approved injection docket number before disposing of salt water.
 8. Notify K.C.C. within 10 days when injection commences or terminates.
- If an alternate 2 completion, cement in the production pipe from below any usable water to surface within 120 days of spud date.

JUL 16 1984

CONSERVATION DIVISION
 Wichita, Kansas

7-16-84

State Corporation Commission of Kansas
 Conservation Division
 200 Colorado Derby Building
 Wichita, Kansas 67202
 (316) 263-3238