

This form shall be filed in duplicate with the Kansas Corporation Commission, 200 Colorado Derby Building, Wichita, Kansas 67202, within ten days after the completion of the well, regardless of how the well was completed.

Attach separate letter of request if the information is to be held confidential. If confidential, only file one copy. Information on side one will be of public record and side two will then be held confidential.

Circle one: Oil, Gas, Dry, SWD, OWWO, Injection. Type and complete ALL sections. Applications must be filed for dual completion, commingling, SWD and injection, T.A.

Attach wireline logs (i.e. electrical log, sonic log, gamma ray neutron log, etc.). KCC # (316) 263-3238. (Rules 82-2-105 & 82-2-125)

OPERATOR American Energies Corporation

API NO. 15-065-21,592-00-00

ADDRESS 575 Fourth Financial Center

COUNTY Graham

Wichita, Kansas 67202

FIELD Wildcat

**CONTACT PERSON Ronald S. Schraeder

PROD. FORMATION

PHONE 316 263-5785

LEASE White

PURCHASER

WELL NO. 1

ADDRESS

WELL LOCATION SE SW NE

DRILLING Circle M Drilling, Inc.

Ft. from Line and

CONTRACTOR

Ft. from Line of

ADDRESS Box 128

the NE SEC. 16 TWP. 7s RGE. 24w


Oberlin, Kansas 67749

WELL PLAT

PLUGGING Sun Cementing

CONTRACTOR

ADDRESS

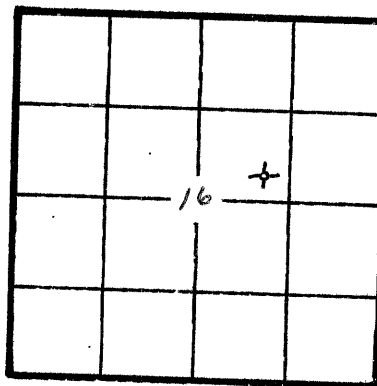

KCC
KGS
(Office Use)

TOTAL DEPTH 4260' PBD

SPUD DATE 3-15-82 DATE COMPLETED 3-25-82

ELEV: GR 2497 DF 2500 KB 2502

DRILLED WITH (X) (ROTARY) (X) TOOLS

Amount of surface pipe set and cemented 265' DV Tool Used? No

AFFIDAVIT

STATE OF Kansas, COUNTY OF Sedgwick SS, I, Ronald S. Schraeder

OF LAWFUL AGE, BEING FIRST DULY SWORN UPON HIS OATH,

DEPOSES THAT HE IS Operations Manager (FOR) (OF) American Energies Corporation

OPERATOR OF THE White LEASE, AND IS DULY AUTHORIZED TO MAKE

THIS AFFIDAVIT FOR AND ON THE BEHALF OF SAID OPERATOR, THAT WELL NO. 1 ON

SAID LEASE HAS BEEN COMPLETED AS OF THE 25th DAY OF March, 19 82, AND THAT

ALL INFORMATION ENTERED HEREIN WITH RESPECT TO SAID WELL IS TRUE AND CORRECT.

FURTHER AFFIANT SAITH NOT.

CONSERVATION DIVISION
Wichita, Kansas

NANCY P. LAMPROS
STATE NOTARY PUBLIC
Sedgwick County, Kansas
My Appl. Exp. 6-13-82

SUBSCRIBED AND SWORN BEFORE ME THIS 5th DAY OF April, 19 82

4-12-82

(s) Ronald S. Schraeder
Nancy P. Lampros
NOTARY PUBLIC
Nancy P. Lampros

MY COMMISSION EXPIRES: June 13, 1982

**The person who can be reached by phone regarding any questions concerning this information. Within 45 days of completion, a witnessed initial test by the Commission is required if the well produces more than 25 BOPD or is located in a Basic Order Pool.

SIDE TWO

WELL LOG

Show all important zones of porosity and contents thereof; cored intervals, and all drill-stem tests, including depth interval tested, cushion used, time tool open, flowing and shut-in pressures, and recoveries.

SHOW GEOLOGICAL MARKERS, LOGS RUN, OR OTHER DESCRIPTIVE INFORMATION.

FORMATION DESCRIPTION, CONTENTS, ETC.	TOP	BOTTOM	NAME	DEPTH
3-23-82: @3879, DST #1 3823-79, Misrun DST #2, 3859-79, Weak Blow 30-30-30-30", Wk. bl. 20", Rec. 5' M w/SO in tool. Hyd. 2062 & 2042#, FPs 19-19 & 19-19#, SIPs 19 & 29#, Temp 117°.				
Electric Log				
Anhyd	2208	+294	+9	
Heeb	3749	-1247	-4	
Lsng.	3790	-1288	-6	
B/KC	3985	-1483	-3	
Pawnee	4082	-1580	-3	
Viola	4210	-1708	+22	
LTD	4257			

Report of all strings set — surface, intermediate, production, etc. **CASING RECORD** (New) or (Used)

Purpose of string	Size hole drilled	Size casing set (in O.D.)	Weight lbs/ft.	Setting depth	Type cement	Sacks	Type and percent additives
Surface	12 1/4	8 5/8	20	256'	Common	160	3%cc 2% gel

LINER RECORD

Top, ft.	Bottom, ft.	Sacks cement

PERFORATION RECORD

Shots per ft.	Size & type	Depth interval

TUBING RECORD

Size	Setting depth	Packer set at

ACID, FRACTURE, SHOT, CEMENT SQUEEZE RECORD

Amount and kind of material used	Depth interval treated

Date of first production	Producing method (flowing, pumping, gas lift, etc.)	Gravity

RATE OF PRODUCTION PER 24 HOURS	Oil	Gas	Water	Gas-oil ratio
	bbls.	bbls.	MCF	bbls.
			%	CFPB

Disposition of gas (vented, used on lease or sold)

Perforations