

STATE CORPORATION COMMISSION OF KANSAS
OIL & GAS CONSERVATION DIVISION

WELL COMPLETION OR RECOMPLETION FORM
ACO-1 WELL HISTORY

DESCRIPTION OF WELL AND LEASE

Operator: License # 4655
Name BHP Petroleum (Americas) Inc.
Address 925 Patton Road
City/State/Zip Great Bend, KS 67530

Purchaser

Operator Contact Person Mr. Gary Misak
Phone 316 792-2756

Contractor: License # 6394
Name Mohawk Drilling, Inc.

Wellsite Geologist Mr. Gary Shaffer
Phone 316 788-3911

Designate Type of Completion

New Well Re-Entry Workover

Oil SMD Temp Abd
 Gas Inj Delayed Comp.
 Dry Other (Core, Water Supply etc.)

If OWO: old well info as follows:

Operator
Well Name
Comp. Date Old Total Depth

WELL HISTORY

Drilling Method:

Mud Rotary Air Rotary Cable

2-25-86 3-4-86 3-5-86
Spud Date Date Reached TD Completion Date
4311
Total Depth PBD

Amount of Surface Pipe Set and Cemented at 264 feet
Multiple Stage Cementing Collar Used? Yes No
If yes, show depth set feet
If alternate 2 completion, cement circulated from feet depth to w/ SX cmt

API NO. 15-065-22,304 80-00

County Graham

NW SE SW Sec 27 Twp 7 Rge 24 East West

990 Ft North from Southeast Corner of Section
3630 Ft West from Southeast Corner of Section
(Note: Locate well in section plat below)


Lease Name Shoemaker Well # 1

Field Name Wildcat

Producing Formation

Elevation: Ground 2411 KB 2421

Section Plat

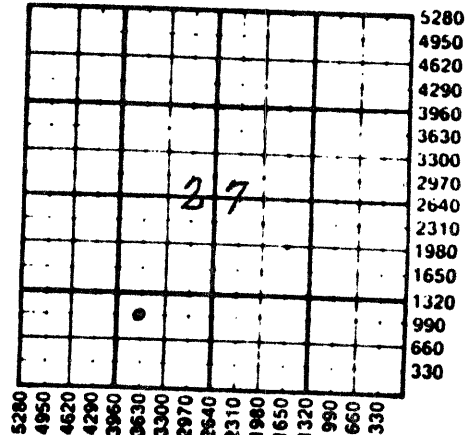

WATER SUPPLY INFORMATION

Disposition of Produced Water: Disposal Repressuring
Docket #

Questions on this portion of the ACO-1 call:
Water Resources Board (913) 296-3717

Source of Water:
Division of Water Resources Permit # T.86-120

Groundwater 1980 Ft North from Southeast Corner
(Well) 2310 Ft West from Southeast Corner of
Sec 14 Twp 8 Rge 24 East West

Surface Water Ft North from Southeast Corner
(Stream, pond etc) Ft West from Southeast Corner
Sec Twp Rge East West

Other (explain)
(purchased from city, R.W.D. #)


INSTRUCTIONS: This form shall be completed in duplicate and filed with the Kansas Corporation Commission, 200 Colorado Derby Building, Wichita, Kansas 67202, within 90 days after completion or recompletion of any well. Rule 82-3-130 and 82-3-107 apply. Information on side two of this form will be held confidential for a period of 12 months if requested in writing and submitted with the form. See rule 82-3-107 for confidentiality in excess of 12 months. One copy of all wireline logs and drillers time log shall be attached with this form. Submit CP-4 form with all plugged wells. Submit CP-111 form with all temporarily abandoned wells.

All requirements of the statutes, rules and regulations promulgated to regulate the oil and gas industry have been fully complied with and the statements herein are complete and correct to the best of my knowledge.

Signature Mary L. Misak
Title Petroleum Engineer Date 4-2-86

Subscribed and sworn to before me this 2nd day of April 1986
Notary Public
Date Commission Expires My Appt. Exp. Sept. 9, 1987

K.C.C. OFFICE USE ONLY
 Letter of Confidentiality Attached
 Wireline Log Received
 Drillers Time Log Received
Distribution
 KCC SMD/Rep NGPA
 KGS Plug Other
(Specify)

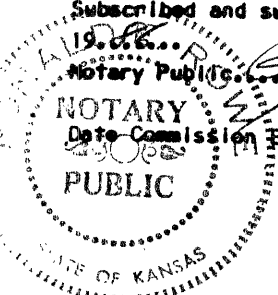

APR - 7 1985
CONSERVATION DIVISION
Wichita, Kansas

4-7-86

Sec 27 Twp 7 Rge 24