

CARD MUST BE TYPED

State of Kansas  
**NOTICE OF INTENTION TO DRILL**  
(see rules on reverse side)

CARD MUST BE SIGNED

Starting Date: 7 30 84  
month day year

API Number 15- 059-23,627-00-00

OPERATOR: License # 8389  
Name Greenwood Resources Inc.  
Address 315 Inverness Way South  
City/State/Zip Englewood, CO 80112  
Contact Person Poul E. Poulsen  
Phone 303/790-1266

NE, NW, NE... Sec 23 Twp 15 S, Rge 20  
(location)  East  West

4820... Ft North from Southeast Corner of Section

1750... Ft West from Southeast Corner of Section

(Note: Locate well on Section Plat on reverse side)

CONTRACTOR: License # 5660 5666  
Name Finch Drilling Co.  
City/State Box 125 Ottawa, KS 66067

Nearest lease or unit boundary line 460' feet.

County Franklin

Lease Name Broers, Joe Well# 11-B

Domestic well within 330 feet:  yes  no

Municipal well within one mile:  yes  no

Well Drilled For: Well Class: Type Equipment:  
 Oil  Swd  Infield  Mud Rotary  
 Gas  Inj  Pool Ext.  Air Rotary  
 OWWO  Expl  Wildcat  Cable

Depth to Bottom of fresh water 52 feet

Lowest usable water formation Lansing Group

Depth to Bottom of usable water 233 feet

Surface pipe by Alternate: 1  2

Surface pipe to be set 72 feet

Conductor pipe if any required N/A feet

Ground surface elevation feet MSL

This Authorization Expires 2/2/85

Approved By 8/2/84 [Signature]

If OWWO: old well info as follows:

Operator

Well Name

Comp Date Old Total Depth

Projected Total Depth 900 feet

Projected Formation at TD Cherokee

Expected Producing Formations Squirrel

I certify that we will comply with K.S.A. 55-101, et seq., plus eventually plugging hole to K.C.C. specifications.

Date 7-30-84 Signature of Operator or Agent

[Signature: Poul E. Poulsen]

Title V.P. Engineering


MHC/KOME 8/2/84 Form C-2/84

Must be filed with the K.C.C. five (5) days prior to commencing well  
 This card void if drilling not started within six (6) months of date received by K.C.C.

RECEIVED  
 STATE CORPORATION COMMISSION  
 82-84  
 AUG 02 1984

Important procedures to follow:

A Regular Section of Land  
 1 Mile = 5,280 Ft.

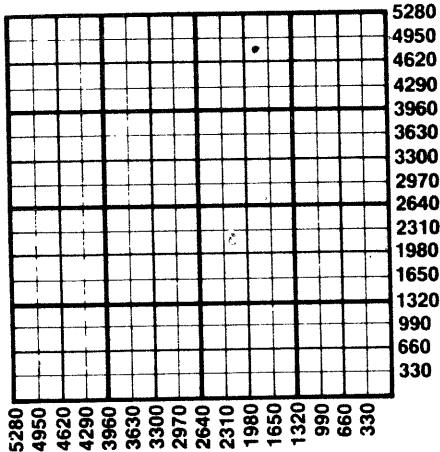

1. Notify District office before setting surface casing. CONSERVATION DIVISION  
Wichita, Kansas
2. Set surface casing by circulating cement to the top.
3. File completion forms ACO-1 with K.C.C. within 90 days of well completion, following instructions on ACO-1, side 1, and including copies of wireline logs.
4. Notify District office 48 hours prior to old well workover or re-entry.
5. Prior to plugging, prepare a plugging plan, then obtain agreement from the appropriate district office for an approved plugging plan.
6. Submit plugging report (CP-4) to K.C.C. after plugging is completed.
7. Obtain an approved injection docket number before disposing of salt water.
8. Notify K.C.C. within 10 days when injection commences or terminates.
9. If an alternate 2 completion, cement in the production pipe from below any usable water to surface within 120 days of spud date.

State Corporation Commission of Kansas  
 Conservation Division  
 200 Colorado Derby Building  
 Wichita, Kansas 67202  
 (316) 263-3238