

CARD MUST BE TYPED

State of Kansas

CARD MUST BE SIGNED

### NOTICE OF INTENTION TO DRILL

(see rules on reverse side)

Expected Spud Date..... 4 month 19 day 1988 year

API Number 15-059-24,329-0000 <sup>10</sup>  
SW SW NW Sec. 24 Twp. 15 S, Rg. 20  East  
2805 West  
5115 Ft. from South Line of Section  
Ft. from East Line of Section

OPERATOR: License # 6142  
Name TOWN OIL COMPANY  
Address RR #4  
City/State/Zip Paola, Kansas 66701  
Contact Person Lester Town  
Phone (913) 294-2125

(Note: Locate well on Section Plat on reverse side)  
Nearest lease or unit boundary line 165 feet  
County FRANKLIN  
Lease Name BROERS Well # 1

CONTRACTOR: License #  
Name COMPANY TOOLS  
City/State

Ground surface elevation feet MSL  
Domestic well within 330 feet: \_\_\_yes  no  
Municipal well within one mile: \_\_\_yes  no  
Depth to bottom of fresh water None  
Depth to bottom of usable water 200  
Surface pipe by Alternate: 1 \_\_\_ 2

Well Drilled For: Well Class: Type Equipment:  
 Oil \_\_\_ Storage \_\_\_ Infield  Mud Rotary  
\_\_\_ Gas \_\_\_ Inj \_\_\_ Pool Ext. \_\_\_ Air Rotary  
\_\_\_ OWWO \_\_\_ Expl  Wildcat \_\_\_ Cable

Surface pipe planned to be set 20  
Conductor pipe required None  
Projected Total Depth 900 feet  
Formation Bartlesville

If OWWO: old well info as follows:  
Operator  
Well Name  
Comp Date Old Total Depth

I certify that well will comply with K.S.A. 55-101, et seq., plus eventually plugging hole to KCC specifications.

Date 4-14-88 Signature of Operator or Agent *Frank Sheppard* Title Agent

For KCC Use:  
Conductor Pipe Required feet; Minimum Surface Pipe Required 20 feet per Alt. X (2)  
This Authorization Expires 10-14-88 Approved By *FCM 4-14-88*


EFFECTIVE DATE: 4-19-88

Must be filed with the K.C.C. five (5) days prior to commencing well  
 This card void if drilling not started within six (6) months of date received by K.C.C.

**Important procedures to follow:**

1. Notify District office before setting surface casing.
2. Set surface casing by circulating cement to the top.
3. File completion forms ACO-1 with K.C.C. within 120 days of well spud date, following instructions on ACO-1, side 1, and including copies of wireline logs.
4. Notify District office 48 hours prior to old well workover or re-entry.
5. Prior to filing Intent, prepare a proposed plugging plan in case well is D & A, then obtain approval of plan when calling district office prior to setting surface pipe.
6. Submit plugging report (CP-4) to K.C.C. after plugging is completed.
7. Obtain an approved injection docket number before disposing of salt water.
8. Notify K.C.C. within 10 days when injection commences or terminates.
9. If an alternate 2 completion, cement in the production pipe from below any usable water to surface within 120 days of spud date.

**A Regular Section of Land**  
**1 Mile = 5,280 Ft.**

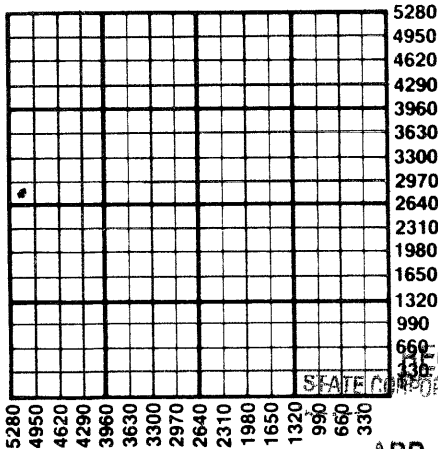

RECEIVED  
 STATE CORPORATION COMMISSION

APR 14 1988

CONSERVATION DIVISION  
 Wichita, Kansas

4-14-88

State Corporation Commission of Kansas  
 Conservation Division  
 200 Colorado Derby Building  
 Wichita, Kansas 67202-1212  
 (316) 263-3238