

* CORRECTED
CARD MUST BE TYPED

State of Kansas
NOTICE OF INTENTION TO DRILL
(see rules on reverse side)

Correction
CARD MUST BE SIGNED
10/24-85

Starting Date:8-18-85.....
month day year

OPERATOR: License #6142.....

NameTown Oil Co.....

AddressRt. 4.....

City/State/ZipPaola, KS 66071.....

Contact PersonLester Town.....

Phone913-294-2125.....

CONTRACTOR: License #COMPANY TOOLS.....

Name

City/State

Well Drilled For: Well Class: Type Equipment:

☒ Oil ☐ Swd ☒ Infield ☐ Mud Rotary

☐ Gas ☐ Inj ☐ Pool Ext. ☒ Air Rotary

☐ OWWO ☐ Expl ☐ Wildcat ☐ Cable

If OWWO: old well info as follows:

Operator

Well Name

Comp Date Old Total Depth

Projected Total Depth800..... feet

Projected Formation at TD.....Bartlesville.....

Expected Producing Formations Bartlesville.....

I certify that we will comply with K.S.A. 55-101, et seq., plus eventually plugging hole to K.C.C. specifications.

Date10-22-85.....
Signature of Operator or Agent

Lester Town

Title ..Partnes.....

API Number 15- 121-26, 635-00-00

f *SE* SW/4 Sec 13 Twp 17 S, Rge 22
(location) ☒ East ☐ West

*.....9.19..... Ft North from Southeast Corner of Section

*...394.8..... Ft West from Southeast Corner of Section

(Note: Locate well on Section Plat on reverse side)

Nearest lease or unit boundary line ...*9.19..... feet.

CountyMiami.....

Lease Name ..Joekel..... Well# ..CW-6...

Domestic well within 330 feet: ☐ yes ☒ no

Municipal well within one mile: ☐ yes ☒ no

Depth to Bottom of fresh water0..... feet

Lowest usable water formation375.....

Depth to Bottom of usable water200..... feet

Surface pipe by Alternate: 1 ☐ 2 ☒

Surface pipe to be set20..... feet
none

Conductor pipe if any required feet

Ground surface elevation2-13-86..... feet MSL

This Authorization Expires8-13-85.....

Approved By


was 50 SW 780 FSL

4600 FEL

**Must be filed with the K.C.C. five (5) days prior to commencing well
This card void if drilling not started within six (6) months of date received by K.C.C.**

Important procedures to follow :

**A Regular Section of Land
1 Mile = 5,280 Ft.**

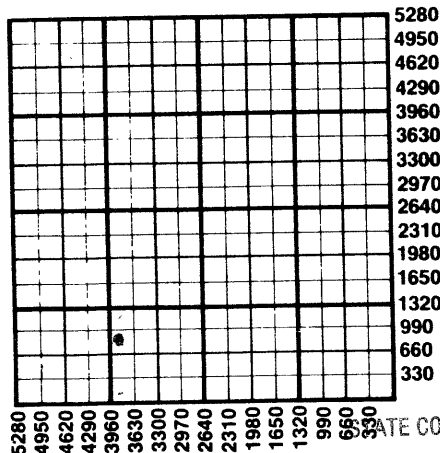

1. Notify District office before setting surface casing.
2. Set surface casing by circulating cement to the top.
3. File completion forms ACO-1 with K.C.C. within 90 days of well completion, following instructions on ACO-1, side 1, and including copies of wireline logs.
4. Notify District office 48 hours prior to old well workover or re-entry.
5. Prior to plugging, prepare a plugging plan, then obtain agreement from the appropriate district office for an approved plugging plan.
6. Submit plugging report (CP-4) to K.C.C. after plugging is completed.
7. Obtain an approved injection docket number before disposing of salt water.
8. Notify K.C.C. within 10 days when injection commences or terminates.
9. If an alternate 2 completion, cement in the production pipe from below any usable water to surface within 120 days of spud date.

RECEIVED
STATE CORPORATION COMMISSION

**State Corporation Commission of Kansas
Conservation Division
200 Colorado Derby Building
Wichita, Kansas 67202
(316) 263-3238**

OCT 2 1955
CONSERVATION DIVISION
Wichita, Kansas