

CORRECTED

CARD MUST BE TYPED

5-1-85

NOTICE OF ^{State of Kansas} INTENTION TO DRILL
(see rules on reverse side)

COLLECTION

CARD MUST BE SIGNED

10-24-85

Starting Date:

month day year

6 14 2

OPERATOR: License #

Name Town Oil Co.

Address Rt. 4

City/State/Zip Paola, KS 66071

Contact Person Lester Town

Phone 913-294-2125

CONTRACTOR: License # Company Tools

Name

City/State

Well Drilled For:

Well Class:

Type Equipment:

Oil Swd

Infield

Mud Rotary

Gas Inj

Pool Ext.

Air Rotary

OWWO Expl

Wildcat

Cable

If OWWO: old well info as follows:

Operator

Well Name

Comp Date Old Total Depth

Projected Total Depth 800. feet

Projected Formation at TD Bartlesville.....

Expected Producing Formations Bartlesville.....

I certify that we will comply with K.S.A. 55-101, et seq., plus eventually plugging hole to K.C.C. specifications.

Date 10-22-85 ... Signature of Operator or Agent

Lester Town Title

was 850 FSC

Partner 3940 FEL

API Number 15-121-26, 529-00-00

IN

East

West

*..SW .SW/4.. Sec 13. Twp 17. S, Rge 22.

* 1219

* 4492 Ft North from Southeast Corner of Section

(Note: Locate well on Section Plat on reverse side)

* 1219

feet

Nearest lease or unit boundary line

Miami

County Joeckel

CW-10

Lease Name

Domestic well within 330 feet : yes no

Municipal well within one mile : yes no

Depth to Bottom of fresh water 0..... feet

Lowest usable water formation

Depth to Bottom of usable water 200..... feet

Surface pipe by Alternate : 1 2

Surface pipe to be set 20..... feet

Conductor pipe if any required none..... feet

Ground surface elevation feet MSL


This Authorization Expires 10-26-85

Approved By 4-26-85

Must be filed with the K.C.C. five (5) days prior to commencing well
This card void if drilling not started within six (6) months of date received by K.C.C.

A Regular Section of Land

1 Mile = 5,280 Ft.

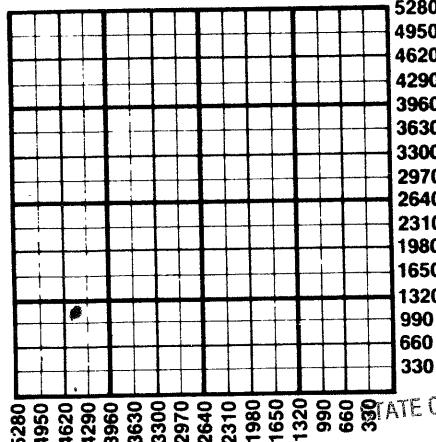

RECEIVED
STATE CORPORATION COMMISSION

CONSERVATION DIVISION
Wichita, Kansas

OCT 24 1980

9. If an alternate 2 completion, cement in the production pipe from below
any usable water to surface within 120 days of spud date.

State Corporation Commission of Kansas
Conservation Division
200 Colorado Derby Building
Wichita, Kansas 67202
(316) 263-3238