


15-065-00466-06-00

STATE OF KANSAS
STATE CORPORATION COMMISSION

Give All Information Completely
Make Required Affidavit
Mail or Deliver Report to:
Conservation Division
State Corporation Commission
800 Bitting Building
Wichita, Kansas

WELL PLUGGING RECORD

NORTH

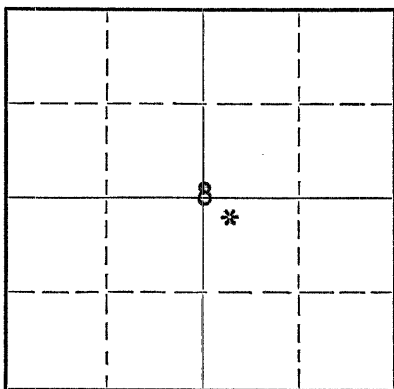

Locate well correctly on above
Section Plat

Graham County. Sec. 8 Twp. 7 Rge. 25 (E) W (W)
Location as "NE/CNW $\frac{1}{4}$ SW $\frac{1}{4}$ " or footage from lines NW-NW-SE
Lease Owner S. A. Berwick - Hall - Jones
Lease Name Abernathy Well No. 1
Office Address P. O. Box 64, Great Bend, Kansas
Character of Well (completed as Oil, Gas or Dry Hole) Dry Hole
Date well completed January 6 19 54
Application for plugging filed January 6 19 54
Application for plugging approved Yes 19 54
Plugging commenced January 6 19 54
Plugging completed January 6 19 54
Reason for abandonment of well or producing formation Dry

If a producing well is abandoned, date of last production None 19 54
Was permission obtained from the Conservation Division or its agents before plugging was commenced? Yes

Name of Conservation Agent who supervised plugging of this well Eldon Petty
Producing formation None Depth to top Bottom Total Depth of Well 4230 Feet
Show depth and thickness of all water, oil and gas formations.

OIL, GAS OR WATER RECORDS

CASING RECORD

Formation	Content	From	To	Size	Put In	Pulled Out

Describe in detail the manner in which the well was plugged, indicating where the mud fluid was placed and the method or methods used in introducing it into the hole. If cement or other plugs were used, state the character of same and depth placed, from feet to feet for each plug set.

Filled Hole with heavy mud. Bridged hole 205 ft., cemented with
15 sacks, bridged hole 40 ft. and cemented to top

(If additional description is necessary, use BACK of this sheet)

Correspondence regarding this well should be addressed to S. A. Berwick Drilling Company
Address P. O. Box 64, Great Bend, Kansas

1-16-54

STATE OF Kansas, COUNTY OF Barton, ss.
S. A. Berwick (employee of owner) or (owner or operator) of the above-described well,
being first duly sworn on oath, says: That I have knowledge of the facts, statements, and matters herein contained and the log of the above-described well as filed and that the same are true and correct. So help me God.


(Signature) S. A. Berwick

P. O. Box 64, Great Bend, Kansas
(Address)

SUBSCRIBED AND SWORN to before me this 7th day of January, 19 54

My commission expires April 11, 1955

John M. Poon
Notary Public.

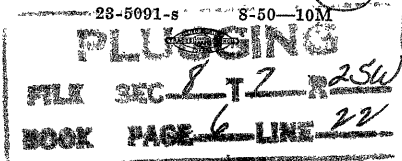

BENSON-MONTIN, ETAL.
1501 Petroleum Building
Oklahoma City, Oklahoma

Abernathy No.1

Total Depth: 4230'
Commenced R. D.: 11/28/53
Completed R. D.: 1/6/54

NW-NW-SE Sec. 8-7-25
Graham County, Kansas
Elevation:
Initial Prod.: Dry
Contractor: S. A. Berwick
Drilling Company

Strata	Depth
Sand	0-207
Shale	207-212
Shale and Shells	212-1380
Sand	1380-1510
Shale and Shells	1510-1680
Shale	1680-2115
Shale and Shells	2115-2130
Anhydrite	2130-2165
Shale and Shells	2165-2480
Shale	2480-3310
Shale and Lime	3310-3650
Lime	3650-3883
Shale and Lime	3883-4040
Shale	4040-4106
Shale and Lime	4106-4230

I hereby certify the above a true and correct log of said well as reflected by the daily drilling report.


S. A. BERWICK DRILLING COMPANY

By S. A. Berwick
S. A. Berwick Owner

Signed and sworn to in my presence this 14th day of January, 1954, by S. A. Berwick, owner of the S. A. Berwick Drilling Company.

John W. Dore
Notary Public

My Commission Expires: April 11, 1955

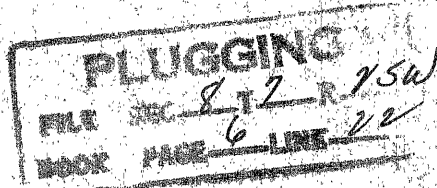

1-16-54