


15-065-02355-06-00

STATE OF KANSAS
STATE CORPORATION COMMISSION

Give All Information Completely
Make Required Affidavit
Mail or Deliver Report to:
Conservation Division
State Corporation Commission
211 No. Broadway
Wichita, Kansas

WELL PLUGGING RECORD

NORTH

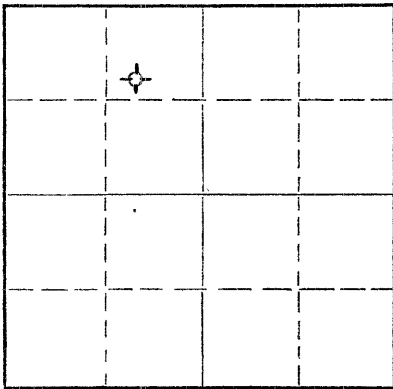

Locate well correctly on above
Section Plat

GRAHAM County, Sec. 20 Twp. 7S Rge. 25W (E) (W)

Location as "NE/CNW%SW%" or footage from lines SW NE NW

Lease Owner C-G DRILLING & NATE APPLEMAN

Lease Name KENDALL Well No. 2

Office Address Rule Building, Wichita, Kansas

Character of Well (completed as Oil, Gas or Dry Hole) Dry Hole

Date well completed 10-8-57 19

Application for plugging filed 10-8-57 19

Application for plugging approved 10-8-57 19

Plugging commenced 10-8-57 19

Plugging completed 10-8-57 19

Reason for abandonment of well or producing formation too low structurally

If a producing well is abandoned, date of last production 19

Was permission obtained from the Conservation Division or its agents before plugging was commenced? yes

Name of Conservation Agent who supervised plugging of this well Eldon Petty

Producing formation Depth to top Bottom Total Depth of Well 3940 Feet

Show depth and thickness of all water, oil and gas formations.

OIL, GAS OR WATER RECORDS

CASING RECORD

FORMATION	CONTENT	FROM	TO	SIZE	PUT IN	PULLED OUT
				8-5/8	295	none

Describe in detail the manner in which the well was plugged, indicating where the mud fluid was placed and the method or methods used in introducing it into the hole. If cement or other plugs were used, state the character of same and depth placed, from feet to feet for each plug set.

Filled hole with heavy mud to 650' set plug and cemented with 20 sx thru pipe. Filled with heavy mud to 285' set plug & cemented with 20 sx cement. Filled hole with heavy mud to 40' and built solid bridge and cemented with 10 sx cement. Plugging Complete.

RECEIVED
STATE CORPORATION COMMISSION
OCT 17 1957
CONSERVATION DIVISION
Wichita, Kansas

(If additional description is necessary, use BACK of this sheet)

Name of Plugging Contractor K & E DRILLING, INC. 10-17-57

Address 719 Union Center Building, Wichita 2, Kansas

STATE OF KANSAS, COUNTY OF SEDGWICK, ss.

Jay H. Galloway (employee of owner) or (owner or operator) of the above-described well, being first duly sworn on oath, says: That I have knowledge of the facts, statements, and matters herein contained and the log of the above-described well as filed and that the same are true and correct. So help me God.

(Signature) Jay H. Galloway of C-G DRILLING CO.
Rule Building, Wichita, Kansas (Address)

SUBSCRIBED AND SWORN TO before me this 16 day of October, 1957

My commission expires May 20, 1959

Vicky Jacobs Notary Public.

PLUGGING
FILE SEC 20 T 7 R 25W
BOOK PAGE 53 LINE 37

WELL

LOG

15-065-02355-00-00

OPERATOR: C-G DRILLING & NATE APPLEMAN
Rule Building
Wichita, Kansas

FARM NAME: #2 KENDALL

CONTRACTOR: K & E DRILLING, INC.
719 Union Center
Wichita 2, Kansas

LOCATION: SW NE NW
Sec. 20-7E-25W
Graham County, Kansas

CASING: 8-5/8" @ 295 (185 sx)

COMMENCED: 10-1-57
COMPLETED: 10-8-57

R.T.D. 3940'

PRODUCTION: D & A

FORMATION RECORD

Depths shown indicate bottom of formations encountered

Surface Soil & Sand	40
Sand and Clay	190
Clay & Blue Shale	295
Shale & Shells	1800
Sand	1980
Red Bed	2195
Anhydrite	2230
Shale & Shells	2635
Shale & Lime	3040
Lime	3180
Lime & Shale	3530
Shale & Lime	3675
Lime & Shale	3716
Lime	3940
R.T.D.	3940

CERTIFICATION

STATE OF KANSAS)
) SS:
COUNTY OF SEDGWICK)

RECEIVED
OCT 17 1957
CONSERVATION DIVISION
Wichita, Kansas
10-17-57

I, Clinton Engstrand, of K & E DRILLING, INC. upon oath state that the above and foregoing is a true and correct copy of the log of the #2 KENDALL.

Clinton Engstrand

Clinton Engstrand



described and sworn to before me this 15th day of October 1957.

Patricia M. Edwards

Patricia M. Edwards, Notary Public

My Commission expires: 11 August 1958.

PLUGGING			
FILE	SEC	T	R
BOOK	PAGE	LINE	

PLUGGING			
FILE	SEC	T	R
BOOK	PAGE	LINE	