


15-065-02961-00-00

Give All Information Completely
Make Required Affidavit
Mail or Deliver Report to:
Conservation Division
State Corporation Commission
211 No. Broadway
Wichita, Kansas

WELL PLUGGING RECORD

NORTH

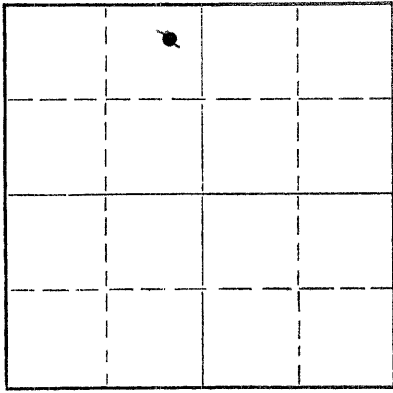

Locate well correctly on above
Section Plat

Graham County. Sec. 20 Twp. 7 Rge. 25W (E) (W)
NE NE NW

Location as "NE/CNW/SW" or footage from lines

Lease Owner C-G Drilling Co.

Lease Name Kendall Well No. 1

Office Address 107 Rule Bldg.

Character of Well (completed as Oil, Gas or Dry Hole) Plugged and Abandoned

Date well completed June 14 1957

Application for plugging filed June 26 1963

Application for plugging approved June 26 1963

Plugging commenced June 26 1963

Plugging completed June 26 1963

Reason for abandonment of well or producing formation No longer commercial

If a producing well is abandoned, date of last production June 11 1963

Was permission obtained from the Conservation Division or its agents before plugging was commenced? Yes

Name of Conservation Agent who supervised plugging of this well Eldon Petty Hays, Kansas

Producing formation _____ Depth to top _____ Bottom _____ Total Depth of Well 4202 Feet

Show depth and thickness of all water, oil and gas formations.

OIL, GAS OR WATER RECORDS

CASING RECORD

FORMATION	CONTENT	FROM	TO	SIZE	PUT IN	PULLED OUT
				8-5/8	270'	none
				5-1/2	3944'	1216'

Describe in detail the manner in which the well was plugged, indicating where the mud fluid was placed and the method or methods used in introducing it into the hole. If cement or other plugs were used, state the character of same and depth placed, from _____ feet to _____ feet for each plug set.

Plug set @ 3723'. Sanded back to 3705' (with sand) dumped 5 sks. cement w/ dump bailer on top of sand. Pulled casing to 540' Circ. Jel mud 20 sks. - and 20 sks. cement. Pulled pipe to 280'. Plugged again w/20 sks. cement. Also from 35' down to top of 8-5/8" w/10 sks. cement.

RECEIVED
STATE CORPORATION COMMISSION

JUL 30 1963

CONSERVATION DIVISION
Wichita, Kansas

(If additional description is necessary, use BACK of this sheet)
Name of Plugging Contractor Glenn-Smith Pipe Pulling Co. 7-30-63
Address Box 156 Ellinwood, Kansas

STATE OF KANSAS, COUNTY OF SEDGWICK, ss.
G. F. Galloway (employee of owner) or (owner or operator) of the above-described

well, being first duly sworn on oath, says: That I have knowledge of the facts, statements, and matters herein contained and the log of the above-described well as filed and that the same are true and correct. So help me God.

(Signature) G.F. Galloway

107 Rule Bldg.
(Address)

SUBSCRIBED AND SWORN TO before me this 23 day of July 19 63

My commission expires May 20, 1967

Vicky Jacobs
Notary Public.



15-065-02961-00-00

WELL LOG

OPERATOR C-G Drilling Co. SEC. 20-7-25W
 WELL NAME Kendall #1 LOC. NE NE NW
 TOTAL DEPTH 4202' COUNTY Graham
 COMM. COMP. STATE Kansas
 RIG NO. #1 Plugged June 26, 1963 ELEVATION 2561' D.F.
 CASING: 270' 8-5/8" OD Surface Casing PRODUCTION:
 Left in hole. Plugged and
 5-1/2" OD Casing. Left in hole 2728' Abandoned

All measurements taken from the top of rotary bushing.

FROM	TO	FORMATION	DEVIATION FROM VERTICAL	REMARKS:
0	270	Sand-Shale		
270	1550	Shale-Shells		
1550	1790	Shale Shells- Sand Streaks		
1790	1900	Red Bed		
1900	2178	Shale-Red Bed	0' - 0	
2178	2208	Anhydrite		
2208	2455	Shale-Shells		
2455	3445	Shale-Lime		
3445	3560	Lime-Shale		
3560	3630	Shale-Lime		
3630	4130	Lime-Shale		DST #1
4130	4185	Lime-Shale		3714-24
4185	4202	Cong.-Arbuckle		DST #2
				3724-60
				DST #3
				3761-91
				DST #4
				3801-3823
				DST #5
				3842-3861
				DST #6
				3869-80

RECEIVED
STATE CORPORATION COMMISSION

JUL 30 1963

7-30-63

CONSERVATION DIVISION
Wichita, Kansas

STATE OF KANSAS)
) SS.
COUNTY OF SEDGWICK)

The undersigned hereby certifies that to the best of his knowledge and belief, the above facts are true and correct.

C-G DRILLING CO.

By G.F. Galloway

SUBSCRIBED AND SWORN TO, BEFORE ME, THIS 23 day of July, 1963

My commission expires:
May 20, 1967

Vicky Jacobs
Vicky Jacobs - Notary Public