


STATE OF KANSAS
STATE CORPORATION COMMISSION

15-065-02426-00-00

Give All Information Completely
Make Required Affidavit
Mail or Deliver Report to:
Conservation Division
State Corporation Commission
211 No. Broadway
Wichita, Kansas

WELL PLUGGING RECORD

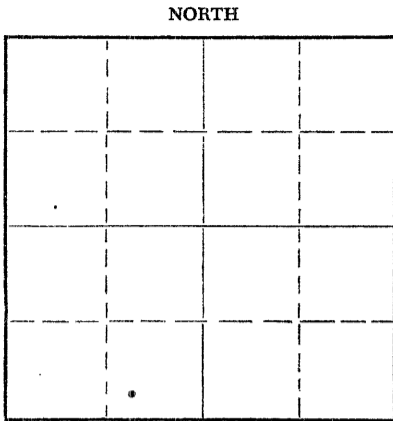

Locate well correctly on above Section Plat

Graham County. Sec. 17 Twp. 7 Rge. (X) 25 (W)
Location as "NE/CNW/SW" or footage from lines 330 S & 1,650 W
Lease Owner Continental Oil Company
Lease Name C. H. Goodrow Well No. 1
Office Address Plainville, Kansas
Character of Well (completed as Oil, Gas or Dry Hole) Dry hole
Date well completed October 11, 19 57
Application for plugging filed 19
Application for plugging approved 19
Plugging commenced October 11, 19 57
Plugging completed October 11, 19 57
Reason for abandonment of well or producing formation No commercial amount of oil encountered
If a producing well is abandoned, date of last production 19
Was permission obtained from the Conservation Division or its agents before plugging was commenced? Yes

Name of Conservation Agent who supervised plugging of this well Eldon Petty
Producing formation _____ Depth to top _____ Bottom _____ Total Depth of Well 3,930 Feet
Show depth and thickness of all water, oil and gas formations.

OIL, GAS OR WATER RECORDS

CASING RECORD

FORMATION	CONTENT	FROM	TO	SIZE	PUT IN	PULLED OUT
				8 5/8"	240'	none
				5 1/2"	3,946'	1,726'

Describe in detail the manner in which the well was plugged, indicating where the mud fluid was placed and the method or methods used in introducing it into the hole. If cement or other plugs were used, state the character of same and depth placed, from _____ feet to _____ feet for each plug set.

Filled to 3,700' with sand. Cemented with 4 sacks of cement. Mudded the hole to 800 feet and cemented with 25 sacks of cement. Mudded to 225 feet and cemented with 20 sacks of cement. Mudded to 30 feet and cemented to surface with 10 sacks of cement.

RECEIVED
STATE CORPORATION COMMISSION
OCT 15 1957
CONSERVATION DIVISION
Wichita, Kansas

10-15-57

(If additional description is necessary, use BACK of this sheet)
Name of Plugging Contractor West Supply Company
Address Chase, Kansas

STATE OF Kansas, COUNTY OF Rooks, ss.
L. E. Powell (employee of owner) or (owner or operator) of the above-described well, being first duly sworn on oath, says: That I have knowledge of the facts, statements, and matters herein contained and the log of the above-described well as filed and that the same are true and correct. So help me God.

(Signature) L. E. Powell
Drawer 98, Plainville, Kansas
(Address)

SUBSCRIBED AND SWORN TO before me this 14th day of October, 19 57

[Signature]
Notary Public.

My commission expires December 2, 1957
CRB-ngg
State Corporation Commission
RFD
File

PLUGGING
FILE SEC 17 T 7 R 25W
BOOK PAGE 53 LINE 38