

15-065-00802-00-00


Give All Information Completely
Make Required Affidavit
Mail or Deliver Report to:
Conservation Division
State Corporation Commission
211 No. Broadway
Wichita, Kansas

WELL PLUGGING RECORD

Graham County. Sec. 17 Twp. 7 Rge. 25W (E) 27 (W)

Location as "NE/CNWxSWx" or footage from lines SW SW SW
Lease Owner C-G Drilling Company
Lease Name Goodrow Well No. #1
Office Address 107 Rule Building, Wichita, Kansas
Character of Well (completed as Oil, Gas or Dry Hole) oil
Date well completed _____ 19____
Application for plugging filed 2-12 1963
Application for plugging approved _____ 19____
Plugging commenced 2-12 1963
Plugging completed 2-15 1963
Reason for abandonment of well or producing formation depleted

If a producing well is abandoned, date of last production Feb 1963
Was permission obtained from the Conservation Division or its agents before plugging was commenced? yes

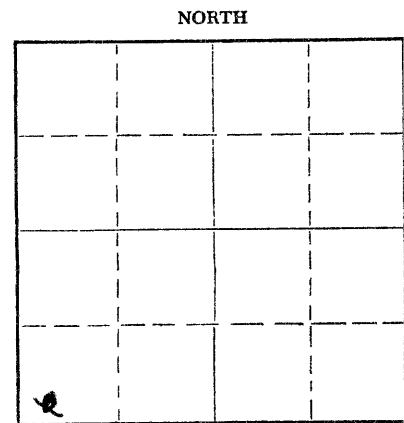

Locate well correctly on above Section Plat

Name of Conservation Agent who supervised plugging of this well Eldon Petty
Producing formation _____ Depth to top _____ Bottom _____ Total Depth of Well 3920 Feet
Show depth and thickness of all water, oil and gas formations.

OIL, GAS OR WATER RECORDS

CASING RECORD

FORMATION	CONTENT	FROM	TO	SIZE	PUT IN	PULLED OUT
		0	277	8 5/8"	277	none
		0	3918	5 1/2"	3918	2707.76

Describe in detail the manner in which the well was plugged, indicating where the mud fluid was placed and the method or methods used in introducing it into the hole. If cement or other plugs were used, state the character of same and depth placed, from _____ feet to _____ feet for each plug set.

Pushed plug with bailer to 3900'. Set 10' rock bridge.
Mixed 4 sacks of cement and dumped at 3890'. Mixed 10 sacks of gel and 20 sacks of cement, dumped at 540'.
Pulled 4 joints of pipe and mixed 20 sacks of cement, dumped at 270'. Finished pulling pipe. Capped hole with 10 sacks of cement.

RECEIVED
STATE CORPORATION COMMISSION

FEB 28 1963

CONSERVATION DIVISION
Wichita, Kansas

(If additional description is necessary, use BACK of this sheet)

Name of Plugging Contractor Pipe Pullers, Inc.
Address Box 486, Ellinwood, Kansas

2-28-63

STATE OF Kansas, COUNTY OF Barton, ss.
Dean Wells (employee of owner) or (~~owner or operator~~) of the above-described

well, being first duly sworn on oath, says: That I have knowledge of the facts, statements, and matters herein contained and the log of the above-described well as filed and that the same are true and correct. So help me God.

(Signature) Dean Wells

Ellinwood, Kansas

(Address)

SUBSCRIBED AND SWORN to before me this 18th day of February, 1963

[Signature]

My commission expires July 7, 1964

Notary Public.

15-065-00802-00-00

W E L L L O G

OPERATOR	C-G Drilling Co. & N. Appleman Co.	SEC.	17-7-25W
WELL NAME	Goodrow #1	LOC.	SW SW SW
TOTAL DEPTH	3920'	COUNTY	Graham
COMM.	Drilling COMP. Plugged Feb. 15, 1962	STATE	Kansas
RIG NO.	2	ELEVATION	2568' R.B.
CASING:	277.70 (13 jts. 8-5/8" OD Surface Casing. Left in hole. 5-1/2" OD Casing. Left in hole 1210.24	PRODUCTION:	Plugged & Abandoned

All measurements taken from the top of rotary bushing.

FROM	TO	FORMATION	DEVIATION FROM VERTICAL	REMARKS:
0	230	Sand-Shale		
230	277	Shale		
277	1155	Shale-Sand		
1155	1225	Sand-Shell		
1225	2180	Shale-Shell		
2180	2218	Anhydrite	0° - 2500	DST 3710-3723'
2218	2830	Shale-Shell	0° - 2750	DST 3726-3740'
2830	3380	Shale-Lime	0° - 3000	DST 3748-3770'
3380	3640	Lime-Shale	0° - 3250	DST 3798-3831'
3640	3920	Lime		DST 3841-3860'

RECEIVED
STATE CORPORATION COMMISSION
FEB 28 1963
2-28-63
CONSERVATION DIVISION
Wichita, Kansas

STATE OF KANSAS)
) SS.
COUNTY OF SEDGWICK)

The undersigned hereby certifies that to the best of his knowledge and belief, the above facts are true and correct.

C-G DRILLING CO.

By Jay H. Galloway
Jay H. Galloway

Vicky Jacobs
Vicky Jacobs - Notary Public

SUBSCRIBED AND SWORN TO, BEFORE ME, THIS 15 day of February, 1963.

My commission expires:
May 20, 1963

