


15-065-02354-0000

STATE OF KANSAS
STATE CORPORATION COMMISSION

Give All Information Completely
Make Required Affidavit
Mail or Deliver Report to:
Conservation Division
State Corporation Commission
211 No. Broadway
Wichita, Kansas

WELL PLUGGING RECORD

NORTH

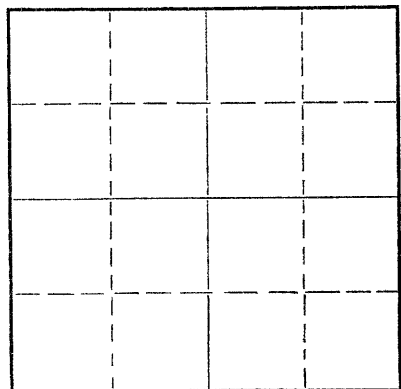

Locate well correctly on above
Section Plat

Graham County. Sec. 20 Twp. 7S Rge. 25 (E) W (W)
Location as "NE/CNW/SW" or footage from lines W/2 NW/4 NE/4
Lease Owner R. W. Shields
Lease Name Goodrow Well No. 1
Office Address 308 Rule Building, Wichita, Kansas
Character of Well (completed as Oil, Gas or Dry Hole) Dry Hole
Date well completed April 21 19 58
Application for plugging filed April 21 19 58
Application for plugging approved April 21 19 58
Plugging commenced April 21 19 58
Plugging completed April 21 19 58
Reason for abandonment of well or producing formation Dry Hole

If a producing well is abandoned, date of last production _____ 19____
Was permission obtained from the Conservation Division or its agents before plugging was commenced? Yes

Name of Conservation Agent who supervised plugging of this well Al Fabrious, Hill City, Kansas
Producing formation _____ Depth to top _____ Bottom _____ Total Depth of Well 3900 Feet
Show depth and thickness of all water, oil and gas formations.

OIL, GAS OR WATER RECORDS

CASING RECORD

FORMATION	CONTENT	FROM	TO	SIZE	PUT IN	PULLED OUT
		0	281	8 5/8"	281	none

Describe in detail the manner in which the well was plugged, indicating where the mud fluid was placed and the method or methods used in introducing it into the hole. If cement or other plugs were used, state the character of same and depth placed, from _____ feet to _____ feet for each plug set.

From 3900' to 510' - heavy rotary mud
510' to 447' - plug, 20 sacks cement
447' to 270' - heavy rotary mud
270' to 222' - plug, 15 sacks cement
222' to 40' - heavy rotary mud
40' to 6' - plug, 1/2 sack hulls, 10 sacks cement
6' to 0 - cellar

4-24-58

(If additional description is necessary, use BACK of this sheet)
Name of Plugging Contractor Peel Brothers, Inc.
Address Box 88, Hoisington, Kansas

STATE OF Kansas COUNTY OF Barton, ss.
Peel Brothers, Inc. (employee of owner) or (~~owner or operator~~) of the above-described well, being first duly sworn on oath, says: That I have knowledge of the facts, statements, and matters herein contained and the log of the above-described well as filed and that the same are true and correct. So help me God. Peel Brothers, Inc.

(Signature) BY [Signature]
Box 88, Hoisington, Kansas
(Address)

SUBSCRIBED AND SWORN TO before me this 23rd day of April, 19 58

[Signature]
Notary Public.

My commission expires April 27, 1960

PLUGGING
FILED SEC 20 T 7 R 25 W
BOOK PAGE 95 LINE 43

15-065-62356-00-00

DRILLERS' LOG

Well Owner: R. W. Shields
Farm Name: Goodrow Well No. 1
Commenced: 3/30/58
Completed: 4/21/58
Total Depth: 3900'
Casing: 8 5/8" @ 281' cemented

Contractor: Peel Brothers, Inc.

W/2 NW/4 NE/4
Sec. 20-7S-25W
Graham County, Kansas

Elevation:

Production: Dry

Figures below indicate bottoms of formations:

Shale	0 -	120
Sand and shale		220
Shale		281
Shale and shells		.870
Shale and sand		1085
Shale and shells		1160
Shale and red bed		1505
Shale and lime		1590
Lime		1625
Shale		2155
Anhydrite		2180
Red bed		2340
Lime		2510
Shale and lime		2910
Shale		2935
Shale and lime		3085
Lime		3225
Shale and lime		3400
Lime		3475
Shale and lime		3665
Lime		3900
Total Depth		3900

This is to certify that the above information is to the best of our knowledge, true and correct.

PEEL BROTHERS, INC.

BY *Robert F. Peel*

SUBSCRIBED AND SWORN to before me this 23rd day of April, 1958

My commission expires: April 27, 1960

Rich Brant
Notary Public

RECEIVED
APR 24 1958
DIVISION
Graham County, Kansas

20 7 25 W
CASE 95 LINE 43