


15-065-01072-00-00

Give All Information Completely  
Make Required Affidavit  
Mail or Deliver Report to:  
Conservation Division  
State Corporation Commission  
211 No. Broadway  
Wichita, Kansas

WELL PLUGGING RECORD

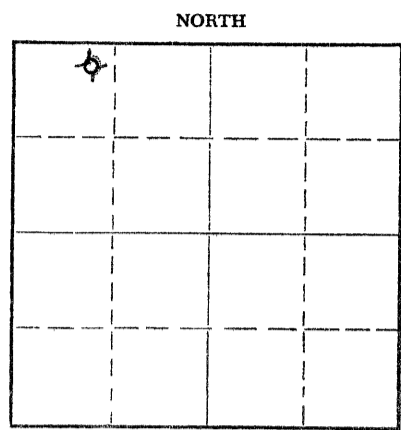

Locate well correctly on above  
Section Plat

Graham County, Sec. 22 Twp. 7S Rge. 25 (E) W (W)  
Location as "NE/CNW/SW" or footage from lines NE NW NW  
Lease Owner C-G Drilling Co.  
Lease Name Harry Toll Well No. 1  
Office Address 107 Rule Building, Wichita, Kansas  
Character of Well (completed as Oil, Gas or Dry Hole) Dry Hole  
Date well completed October 28, 1964 19 64  
Application for plugging filed October 28, 19 64  
Application for plugging approved October 28, 19 64  
Plugging commenced October 28, 19 64  
Plugging completed October 28, 19 64  
Reason for abandonment of well or producing formation Too low structurally

If a producing well is abandoned, date of last production \_\_\_\_\_ 19 \_\_\_\_\_  
Was permission obtained from the Conservation Division or its agents before plugging was commenced? Yes

Name of Conservation Agent who supervised plugging of this well W. L. Nichols, Morland, Kansas  
Producing formation \_\_\_\_\_ Depth to top \_\_\_\_\_ Bottom \_\_\_\_\_ Total Depth of Well 3945 Feet  
Show depth and thickness of all water, oil and gas formations.

OIL, GAS OR WATER RECORDS

CASING RECORD

FORMATION	CONTENT	FROM	TO	SIZE	PUT IN	PULLED OUT
				8-5/8"	243.41'	None

Describe in detail the manner in which the well was plugged, indicating where the mud fluid was placed and the method or methods used in introducing it into the hole. If cement or other plugs were used, state the character of same and depth placed, from \_\_\_\_\_ feet to \_\_\_\_\_ feet for each plug set.

Filled hole with heavy mud to 200'. Set plug. Put in 20 sacks cement. Filled with heavy mud to 180'. Set plug. Put in 1/2 sack hulls and 20 sacks cement. Filled with heavy mud to 70'. Set plug. Filled to top with 1/2 sack hulls and 10 sacks cement.

RECEIVED  
STATE CORPORATION COMMISSION

NOV 4 1964

CONSERVATION DIVISION  
Wichita, Kansas

Name of Plugging Contractor C-G Drilling Co. (If additional description is necessary, use BACK of this sheet)  
Address 107 Rule Building, Wichita 2, Kansas 11-4-64

STATE OF KANSAS, COUNTY OF SEDGWICK, ss. G. F. GALLOWAY

(employee of owner) or (owner or operator) of the above-described well, being first duly sworn on oath, says: That I have knowledge of the facts, statements, and matters herein contained and the log of the above-described well as filed and that the same are true and correct. So help me God.

(Signature) G. F. Galloway

107 Rule Building  
(Address)

SUBSCRIBED AND SWORN TO before me this 2nd day of November, 1964

My commission expires May 20, 1967

Vicky Jacobs  
Notary Public.

15-065-01072-00-00

W E L L    L O G

OPERATOR: C-G DRILLING CO.  
 WELL NAME: HARRY TOLL #1      LOCATION: NE NW NW Sec. 22-7S-25W  
 COUNTY: GRAHAM      STATE: KANSAS  
 WELL COMMENCED: 10/19/64      WELL COMPLETED: 10/28/64  
 ELEVATION: 2524' K.B.      TOTAL DEPTH: 3945'  
 PRODUCTION: D & A      RIG NO: 2  
 CASING - 8-5/8": Set 243.41' (7 jts.) New 20#  
                   5-1/2": \_\_\_\_\_

All Measurements taken from the top of rotary bushing.

FROM	TO	FORMATION	DEVIATION FROM VERTICAL	REMARKS:
0	175	Sand & Shale		
175	195	Shale		
195	220	Sand		
220	350	Shale		
350	915	Shale & Sand	500' - 0°	
915	1100	Shale	1000' - 1/4°	
1100	1250	Sand & Shale		
1250	1750	Shale	1500' - 1/2°	
1750	1955	Sand		
1955	1995	Shale		
1995	2175	Red Bed	2000' - 1/2°	
2175	2208	Anhydrite		
2208	2485	Shale		
2485	2570	Shale & Shells	2500' - 1/2°	
2570	3674	Lime & Shale		
3674	3730	Lime		
3730	3810	Lime & Shale		
3810	3945	Lime		

RECEIVED  
STATE CORPORATION COMMISSION

NOV 4 1964  
11-4-64  
CONSERVATION DIVISION  
Wichita, Kansas

STATE OF KANSAS  
COUNTY OF SEDGWICK) SS:

The undersigned hereby certifies that to the best of his knowledge and belief, the above facts are true and correct.

C-G DRILLING CO.

By

G. F. Galloway

SUBSCRIBED AND SWORN TO, BEFORE ME, This 2nd day of November, 1964.

My comm. exp: May 20, 1967

Vicky Jacobs  
Vicky Jacobs - Notary Public