

CARD MUST BE TYPED

State of Kansas
NOTICE OF INTENTION TO DRILL
(see rules on reverse side)

CARD MUST BE SIGNED

Starting Date: 5-9-85
month day year

OPERATOR: License # 9545 9542
Name .. Bob Myers ..

Address .. 11945 Forestwood Drive ..

City/State/Zip .. Dallas, TX 75234 ..

Contact Person .. Jack L. Partridge ..

Phone 316-262-1841

CONTRACTOR: License # 5422

Name .. Abercrombie Drilling, Inc.

City/State .. Wichita, KS 67202

Well Drilled For: Well Class: Type Equipment:
 Oil Swd Infield Mud Rotary
 Gas Inj Pool Ext. Air Rotary
 OWWO Expl Wildcat Cable

If OWWO: old well info as follows:
Operator ..
Well Name ..
Comp Date Old Total Depth ..
Projected Total Depth 3950 feet
Projected Formation at TD .. Lansing, KC ..
Expected Producing Formations Lansing, KC ..

API Number 15- 065-22,185-0000

.. SW NW SW .. Sec 17. Twp 7. S, Rge 25. East
(location) West

..... 1590 Ft North from Southeast Corner of Section
..... 4950 Ft West from Southeast Corner of Section
(Note: Locate well on Section Plat on reverse side)

Nearest lease or unit boundary line 330 feet.
County Graham ..
Lease Name Myers-Brown Well# 3

Domestic well within 330 feet : yes no
Municipal well within one mile : yes no

Depth to Bottom of fresh water 150 feet
Lowest usable water formation Dakota ..
Depth to Bottom of usable water 1350 feet
Surface pipe by Alternate : 1 2
Surface pipe to be set 300 feet
Conductor pipe if any required .. None feet
Ground surface elevation feet MSL
This Authorization Expires 11-7-85
Approved By 5-7-85 [Signature]

I certify that we will comply with K.S.A. 55-101, et seq., plus eventually plugging hole to K.C.C. specifications.

Date 5-7-85 Signature of Operator or Agent

[Signature] Title V.P. Abercrombie Drilling
Jack L. Partridge


RECEIVED
STATE CORPORATION COMMISSION

Must be filed with the K.C.C. five (5) days prior to commencing well
drilling. If drilling not started within six (6) months of date received by K.C.C.

MAY 7 1985

5-7-85-

CONSERVATION DIVISION
Wichita, Kansas
A Regular Section of Land
1 Mile = 5,280 Ft.

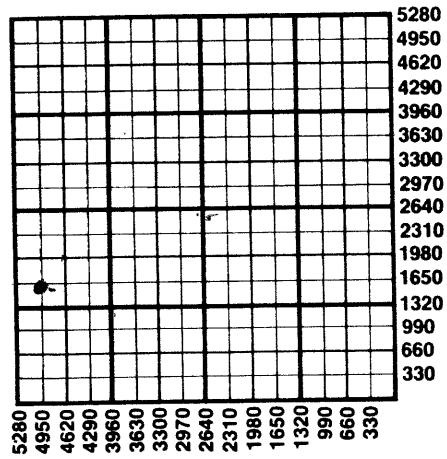

Important procedures to follow :

1. Notify District office before setting surface casing.
2. Set surface casing by circulating cement to the top.
3. File completion forms ACO-1 with K.C.C. within 90 days of well completion, following instructions on ACO-1, side 1, and including copies of wireline logs.
4. Notify District office 48 hours prior to old well workover or re-entry.
5. Prior to plugging, prepare a plugging plan, then obtain agreement from the appropriate district office for an approved plugging plan.
6. Submit plugging report (CP-4) to K.C.C. after plugging is completed.
7. Obtain an approved injection docket number before disposing of salt water.
8. Notify K.C.C. within 10 days when injection commences or terminates.
9. If an alternate 2 completion, cement in the production pipe from below any usable water to surface within 120 days of spud date.

State Corporation Commission of Kansas
Conservation Division
200 Colorado Derby Building
Wichita, Kansas 67202
(316) 263-3238