


WELL PLUGGING RECORD

15-069-21666-00-00

Give All Information Completely
 Make Required Affidavit

COUNTY Graham SEC. 25 TWP. 7 S RGE. 25 E/W
 Location as in quarters or footage from lines:

330 FSL & 330 FWL of the SW $\frac{1}{4}$

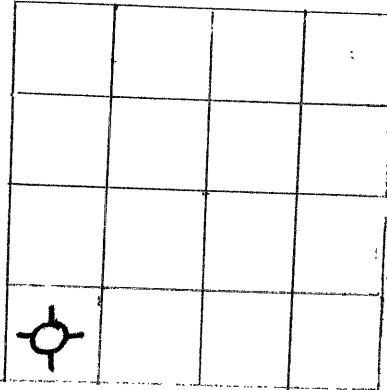

Locate Well
 correctly on above
 Section Platt.

Lease Owner Kissinger Exploration, Inc.

Lease Name Keith

Well No. 13C-24

Office Address 410 Seventeenth Street, Suite 850, Denver, CO 80202

Character of Well (Completed as Oil, Gas or Dry Hole): Dry

Date Well Completed 7/25/82

Application for plugging filed 7/27/82

Plugging commenced 7/25/82

Plugging completed 7/25/82

Reason for abandonment of well or producing formation

wildcat - dry

Was permission obtained from the Conservation Division or it's
 Agent's before plugging was commenced? Yes

Name of Conservation Agent who supervised plugging of this well Gilbert Scheck

Producing formation None Depth to top _____ bottom T.D.

Show depth and thickness of all water, oil and gas formations.

OIL, GAS OR WATER RECORDS

Casing Record

Formation	Content	From	To	Size	Put in	Pulled Out

Describe in detail the manner in which the well was plugged, indicating where the mud
 fluid was placed and the method or methods used in introducing it into the hold. If cement
 or other plugs were used, state the character of same and depth placed, from _____ feet
 to _____ feet for each plug set.

Plug #1 set at 1200' 2/80 sax of 50/50 POS, 4% gel, 3% CC

Plug #2 set at 260' w/40 sax "

Plug #3 (Bridge Plug) at 40' w/10 sax "

Rathole w/ 10 sax

Mousehole w/10 sax

PD 3:30 PM 7/25/82

STATE CORPORATION COMMISSION
 RECEIVED
 AUG 16 1982
 CONSERVATION DIVISION
 Wichita, Kansas

(If additional description is necessary, use BACK of this sheet)

Name of Plugging Contractor Kissinger Drilling, Inc.

410 17th Street, Suite 850, Denver, CO 80202

8-16-82

STATE OF COLORADO COUNTY OF DENVER, ss.
KISSINGER EXPLORATION, INC.

(employee of owner) or (owner or operator) of the
 above-described well, being first duly sworn on oath, says: That I have knowledge of the
 facts, statements, and matters herein contained and the log of the above-described well as
 filed and that the same are true and correct. So help me God.

(Signature)

410 17th Street, Suite 850, Denver, CO 80202
 (Address)

SUBSCRIBED AND SWORN TO before me this 27th day of July, 19 82

Sheila M. Bielak

Sheila M. Bielak

Notary Public.

My Commission expires: June 20, 1984