


Give All Information Completely  
Make Required Affidavit  
Mail or Deliver Report to:  
Conservation Division  
State Corporation Commission  
212 No. Market  
Wichita, Kansas

WELL PLUGGING RECORD

GRAHAM County, Sec. 26 Twp. 7 Rge. 25 (E) W (W)

Location as "NE/CNW/SW" or footage from lines NE NE SE  
Lease Owner HALLIBURTON OIL PRODUCING CO.  
Lease Name MOORE #1 Well No.  
Office Address 2915 CLASSEN BLVD. OKLAHOMA CITY, OKLA.  
Character of Well (completed as Oil, Gas or Dry Hole) DRY HOLE  
Date well completed DEC. 2, 1967 19  
Application for plugging filed DEC. 2, 1967 19  
Application for plugging approved DEC 2, 1967 19  
Plugging commenced DEC 2, 1967 19  
Plugging completed DEC 2, 1967 19  
Reason for abandonment of well or producing formation TOO LOW STRUCTURALLY

NORTH

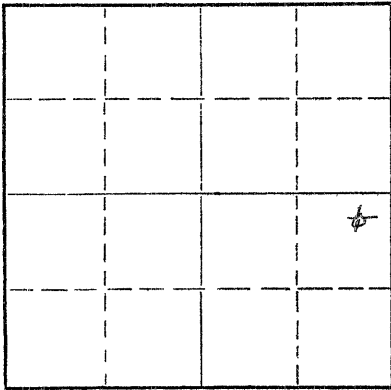

Locate well correctly on above Section Plat

If a producing well is abandoned, date of last production 19  
Was permission obtained from the Conservation Division or its agents before plugging was commenced? YES

Name of Conservation Agent who supervised plugging of this well W. L. NICHOLS, MORELAND, KANSAS  
Producing formation \_\_\_\_\_ Depth to top \_\_\_\_\_ Bottom \_\_\_\_\_ Total Depth of Well 3940 Feet  
Show depth and thickness of all water, oil and gas formations.

OIL, GAS OR WATER RECORDS

CASING RECORD

FORMATION	CONTENT	FROM	TO	SIZE	PUT IN	PULLED OUT
				8-5/8"	274.01	NONE

Describe in detail the manner in which the well was plugged, indicating where the mud fluid was placed and the method or methods used in introducing it into the hole. If cement or other plugs were used, state the character of same and depth placed, from \_\_\_\_\_ feet to \_\_\_\_\_ feet for each plug set.


FILLED WITH HEAVY MUD TO 200'. SET PLUG. PUT IN 25 SACKS CEMENT. FILLED WITH HEAVY MUD TO 300'. SET PLUG. PUT IN 25 SACKS CEMENT. FILLED WITH HEAVY MUD TO 40'. SET PLUG. FILLED TO TOP WITH 10 SACKS CEMENT & 1/2 SACK HULLS.

RECEIVED  
STATE CORPORATION COMMISSION  
DEC 13 1967  
CONSERVATION DIVISION  
WICHITA, KANSAS

(If additional description is necessary, use BACK of this sheet)  
Name of Plugging Contractor C-G DRILLING CO. 12-13-67  
Address 107 RULE BUILDING, WICHITA, KANSAS 67202

STATE OF KANSAS, COUNTY OF \_\_\_\_\_, ss.  
G F GALLOWAY (employee of owner) or (owner or operator) of the above-described well, being first duly sworn on oath, says: That I have knowledge of the facts, statements, and matters herein contained and the log of the above-described well as filed and that the same are true and correct. So help me God.  
(Signature) G F GALLOWAY 107 RULE BUILDING (Address)

SUBSCRIBED AND SWORN to before me this 6th day of DECEMBER, 1967  
My commission expires JAN 23, 1968  
Phyllis McJIMSEY Notary Public.

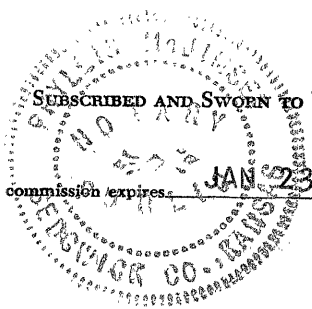

15-065-20107-00-00

WELL LOG

OPERATOR: HALLIBURTON OIL PRODUCING CO.  
 WELL NAME: MOORE #1 LOCATION: NE NE SE 26-7S-25W  
 COUNTY: GRAHAM STATE: KANSAS  
 WELL COMMENCED: 11/22/67 WELL COMPLETED: 12/2/67  
 ELEVATION: 2487 KB TOTAL DEPTH: 3940'  
 PRODUCTION: DRY & ABANDONED RIG NO: #1  
 CASING - 8-5/8": 8 JTS. 274.01' W/200 SACKS QUICKSET  
 5-1/2": \_\_\_\_\_

All Measurements taken from the top of rotary bushing.

FROM	TO	FORMATION	DEVIATION FROM VERTICAL	REMARKS:
0	210	SHALE & SAND	1/2° 500'	DST #1 3727-3746'
210	1580	SHALE	1-3/4° 1000'	DST #2 3760-3776'
1580	1680	SAND	1-3/4° 1500'	DST #3 3764-3795'
1890	2100	RED BED & SHALE	2° 2000'	DST #4 3815-3845'
2100	2130	RED BED	2-1/4° 2500'	DST #5 3850-3880'
2130	2163	ANHYDRITE	2-1/4° 2708'	
2163	2630	SHALE & SHELLS	2° 3000'	
2630	2680	SHALE	1-3/4° 3038'	
2680	2890	LIME & SHALE	1-1/2° 3241'	
2890	3045	LIME	1° 3642'	
3045	3645	LIME & SHALE	1-1/4° 3795'	
3645	3940	LIME		

RECEIVED  
 COMMISSION  
 DEC 13 1967  
 12-13-67  
 DIVISION  
 KANSAS

STATE OF KANSAS )  
 COUNTY OF SEDGWICK ) SS:

The undersigned hereby certifies that to the best of his knowledge and belief, the above facts are true and correct.

C-G DRILLING CO.

By \_\_\_\_\_

SUBSCRIBED AND SWORN TO, BEFORE ME, This 6th day of DEC., 1967.



Phyllis McJimsey  
 Notary Public