

STATE OF KANSAS
STATE CORPORATION COMMISSION

WELL PLUGGING RECORD

Give All Information Completely
Make Required Affidavit
Mail or Deliver Report to
Conservation Division
State Corporation Comm.
245 North Water
Wichita, KS 67202

Thomas County, Sec. 12 Twp. 7 Rge. 36 E/W
Location as "NE/CNW $\frac{1}{4}$ SW $\frac{1}{4}$ " or footage from lines
NW NW 660 N 660 W

Lease Owner Irving Imhof
Lease Name Imhof # 1 Well No. # 1
Office Address Brewster, Kansas 67732

Character of Well (Completed as Oil, Gas or Dry Hole)
Dry hole


Date Well completed 6/20 1979
Application for plugging filed 6/20 1979
Application for plugging approved 6/20 1979
Plugging commenced 6/20 1979
Plugging completed 6/20 1979

Reason for abandonment of well or producing formation
Dry hole

If a producing well is abandoned, date of last production
19

Was permission obtained from the Conservation Division or
its agents before plugging was commenced? yes

Name of Conservation Agent who supervised plugging of this well Gilbert Balthazor
Producing formation _____ Depth to top _____ Bottom _____ Total Depth of Well 1450
Show depth and thickness of all water, oil and gas formations.

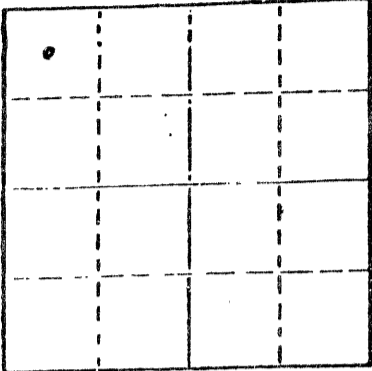

Locate well correctly on above
Section Plot

OIL, GAS OR WATER RECORDS

CASING RECORD

FORMATION	CONTENT	FROM	TO	SIZE	PUT IN	PULLED OUT
Surface casing		0	332	6 5/8	332	0

Describe in detail the manner in which the well was plugged, indicating where the mud fluid was placed and the method or methods used in introducing it into the hold. If cement or other plugs were used, state the character of same and depth placed, from _____ feet to _____ feet for each plug set.

45 sks @ 1420'
20 sks @ 320'
5 sks @ 40'
50 - 50 POS

7/17/79

RECEIVED
STATE CORPORATION COMMISSION
JUL 17 1979

(If additional description is necessary, use BACK of this sheet)

Name of Plugging Contractor Western Well & Pump

CONSERVATION DIVISION
Wichita, Kansas
SS.

STATE OF Kansas COUNTY OF Thomas (employee of owner) or (owner or operator)

of the above-described well, being first duly sworn on oath, says: That I have knowledge of the facts, statements, and matters herein contained and the log of the above-described well as filed and that the same are true and correct. So help me God.

(Signature) Irving Imhof
(Address)

SUBSCRIBED AND SWORN TO before me this 16th day of July, 19

Del Mear
Notary Public.

My commission expires May 18, 1980

