

WELL PLUGGING RECORD

Give All Information Completely
Make Required Affidavit
Mail or Deliver Report to
Conservation Division
State Corporation Comm.
245 North Water
Wichita, KS 67202

Thomas County Sec. 17 Twp. 7S Rge. 36 W
Location as "NE/CNW/SW" or footage from lines _____
NE NW

Lease Owner Beren Corporation

Lease Name Bonnie Well No. #1

Office Address 970 Fourth Financial Center Wichita, KS
67202

Character of Well (Completed as Oil, Gas or Dry Hole) _____
D & A

Date Well completed October 12, 1980 19

Application for plugging filed October 12, 1980 19

Application for plugging approved October 12, 1980 19

Plugging commenced October 12, 1980 19

Plugging completed October 12, 1980 19

Reason for abandonment of well or producing formation _____
No Commercial Production


If a producing well is abandoned, date of last production _____ 19

Was permission obtained from the Conservation Division or its agents before plugging was commenced? Yes

Name of Conservation Agent who supervised plugging of this well Gil Balthazor

Producing formation _____ Depth to top _____ Bottom _____ Tl. Depth of Well _____

Show depth and thickness of all water, oil and gas formations.

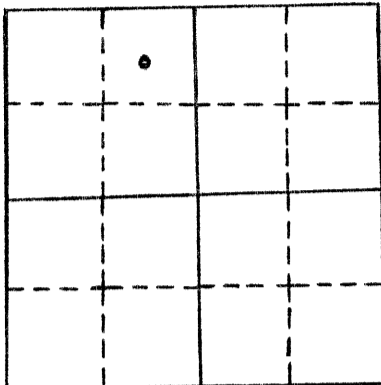

locate well correctly
on above
Section Plot

OIL, GAS OR WATER RECORDS

CASING RECORD

FORMATION	CONTENT	FROM	TO	SIZE	PUT IN	PULLED OUT
surface casing	common	0'	358.06'	8 5/8"	358.06'	0'

Describe in detail the manner in which the well was plugged, indicating where the mud fluid was placed and the method or methods used in introducing it into the hold. If cement or other plugs were used, state the character of same and depth placed, from _____ feet to _____ feet for each plug set.

Plug #1 @ 1800' with 70 sxs

Plug #2 @ 340' with 25 sxs

Plug #3 @ 40' with 10 sxs

5 sxs in rat hole

110 sxs 50-50 poz 6% gel

Plugdown @ 3:30 p.m.

RECEIVED
STATE CORPORATION COMMISSION
OCT 24 1980
CONSERVATION DIVISION
Wichita, Kansas

(If additional description is necessary, use BACK of this sheet)

Name of Plugging Contractor Pioneer Drilling Company, Inc. 308 West Mill Street
Plainville, Kansas 67663

STATE OF Kansas COUNTY OF Sedgwick, ss.

Tyler Sanders (employee of owner) or ~~(owner or operator)~~ of the above described well, being first duly sworn on oath, says: That I have knowledge of the facts, statements, and matters herein contained and the log of the above described well is filed and that the same are true and correct. So help me God.

(Signature) Tyler H. Sanders

(Address) 970 Fourth Financial Center
Wichita, Kansas 67202

SUBSCRIBED AND SWORN TO before me this 23rd day of October, 1980

My commission expires _____


Karen G. Berry
Notary Public

15-193-20212-00-50

WELL LOG

OPERATOR: Beren Corporation

WELL NAME: Bonnie #1 LOCATION: NE NW 17-7S-36W

COUNTY: Thomas STATE: Kansas

WELL COMMENCED: October 1, 1980 WELL COMPLETED: October 12, 1980

ELEVATION: 3403' K.B. TOTAL DEPTH: 4865'

PRODUCTION: D & A RIG NO: #2

CASING - 8 5/8": 358.06' of new 20# cemented with 250 sxs 60-40 poz 2% gel 3% cc cement circ.
5 1/2": _____

ALL MEASUREMENTS TAKEN FROM THE TOP OF ROTARY BUSHING:

FROM	TO	FORMATION	DEVIATION FROM VERTICAL	REMARKS:
0'	367'			
367'	1819'	shale and sand	2009' - 1 1/2 degrees	
1819'	2120'	sand and shale	4450' - 3/4 degree	
2120'	2540'	sand and shale	4865' - 1 degree	
2540'	3024'	shale		
3024'	3037'	anhydrite		
3037'	3059'	anhydrite		
3059'	3372'	shale and lime		
3372'	3525'	shale and lime		
3525'	3609'	shale and lime		
3609'	3760'	shale and lime		
3760'	3920'	shale and lime		
3920'	3977'	shale and lime		
3977'	3985'	shale and lime		
3985'	4139'	shale and lime		
4139'	4232'	shale and lime	4652'	4689'
4232'	4296'	shale and lime	4689'	4732'
4296'	4385'	shale and lime	4732'	4787'
4385'	4450'	shale and lime	4787'	4833'
4450'	4472'	shale and lime	4833'	4865'
4472'	4532'	shale and lime	4865'	RTD
4532'	4538'			
4538'	4600'	shale and lime		
4600'	4631'	shale and lime		
4631'	4652'	shale and lime		

RECEIVED
STATE CORPORATION COMMISSION
OCT 24 1980
10/24/80
CONSERVATION DIVISION
Wichita, Kansas

STATE OF KANSAS
COUNTY OF

The undersigned hereby certifies that to the best of his knowledge and belief, the above facts are true and correct

PIONEER DRILLING CO., INC.

By Connie Jo Austin

SUBSCRIBED AND SWORN TO, BEFORE ME, This 22 day of Sept., 1980

Bernadette Gardner
NOTARY PUBLIC

