

15-193-20225-00-00

STATE OF KANSAS  
STATE CORPORATION COMMISSION  
200 Colorado Derby Bldg.  
Wichita, Kansas 67202

Form CP-4  
Rev. 12-15-80

WELL PLUGGING RECORD

Give All Information Completely  
Make Required Affidavit

COUNTY Thomas SEC. 33 TWP. 7S RGE. 36W E/W  
Location as in quarters or footage from lines:  
660 FNL 660 FWL of SE 1/4


Locate Well  
correctly on above  
Section Platt.

Lease Owner Moble C. Hoover  
Lease Name GLENN ARGABRIGHT Well No. 1  
Office Address 302 NBC Bldg., El Dorado, Ark. 71730  
Character of Well (Completed as Oil, Gas or Dry Hole): Dry Hole  
Date Well Completed 10/09/81  
Application for plugging filed 10/09/81  
Plugging commenced 10/09/81  
Plugging completed 10/09/81  
Reason for abandonment of well or producing formation \_\_\_\_\_

No Commercial quantity of oil or gas encountered.  
Was permission obtained from the Conservation Division or it's  
Agent's before plugging was commenced? YES

Name of Conservation Agent who supervised plugging of this well Carl Goodrow  
Producing formation \_\_\_\_\_ Depth to top \_\_\_\_\_ bottom \_\_\_\_\_ T.D. 4950'

Show depth and thickness of all water, oil and gas formations.

OIL, GAS OR WATER RECORDS

Casing Record:

Formation	Content	From	To	Size	Put in	Pulled Out

Describe in detail the manner in which the well was plugged, indicating where the mud fluid was placed and the method or methods used in introducing it into the hold. If cement or other plugs were used, state the character of same and depth placed, from \_\_\_\_\_ feet to \_\_\_\_\_ feet for each plug set.

Set 1st plug @ 1900' with 70 sx.  
Set 2nd plug @ 400' with 40 sx.  
Set 3rd plug @ 40' Solid Bridge with 10 sx.  
5 sx. in Rathole. 50-50 posmix, 6% gel.

Plug was down @ 3:00 p.m., 10/09/81.

(If additional description is necessary, use BACK of this sheet)  
Name of Plugging Contractor Abercrombie Drilling, Inc.

STATE OF Kansas COUNTY OF Sedgwick, ss.

Jack L. Partridge, Vice Pres. (employee of owner) or (owner or operator) of the above-described well, being first duly sworn on oath, says: That I have knowledge of the facts, statements, and matters herein contained and the log of the above-described well as filed and that the same are true and correct. So help me God.


(Signature) Jack L. Partridge  
801 Union Center, Wichita, KS 67202  
(Address)

SUBSCRIBED AND SWORN TO before me this 14th day of October, 1981

Elizabeth G. Terry  
Elizabeth G. Terry Notary Public

My Commission expires: 7-13-85

*PCW  
10/14/81*

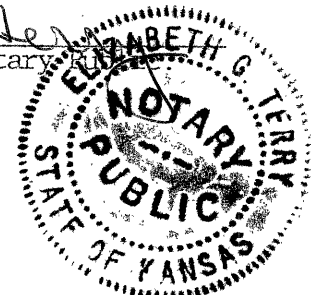

State

CONTRACTORS WELL LOG

15-193-20225-00-00

OPERATOR: Moble C. Hoover  
 CONTRACTOR: Abercrombie Drilling, Inc.  
 WELL NAME: GLENN ARGABRIGHT #1  
 LOCATION: 660 FNL 660 FWL SE/4  
 Thomas County, Kansas  
 SPUD DATE: 9/28/81  
 COMPLETION DATE: 10/09/81

0	100	Soil & Sand
100	380	Sand
380	2390	Shale & Sand
2390	2951	Shale
2951	2985	Anhydrite
2985	3733	Shale
3733	3910	Shale & Lime
3910	4500	Lime & Shale
4500	4625	Lime
4625	4704	Lime & Shale
4704	4900	Lime
4900	4950	Lime & Shale
	4950	Rotary Total Depth

Spud hole @ 2:30 p.m., 9/28/81. Drilled 378' of a 12½" hole. Ran 12 joints of 8 5/8" 20# casing set @ 378' and cemented with 265 sx. 60-40 posmix, 3% c.c., 2% gel. Cement did circulate. Plug was down @ 7:00 p.m., 9/28/81.

4950' TD. Set 1st plug @ 1900' with 70 sx. Set 2nd plug @ 400' with 40 sx. Set 3rd plug @ 40' Solid Bridge with 10 sx. 5 sx. in Rathole. 50-50 posmix, 6% gel. Plug was down @ 3:00 p.m., 10/09/81.

SAMPLE TOPS

Anhydrite	2952' (+ 449)	Stark Sh.	4430' (-1029)
B/Anhydrite	2985' (+ 416)	B/KC	4514' (-1113)
Wabaunsee	3765' (- 364)	Marmaton	4521' (-1120)
Topeka	4028' (- 627)	Pawnee	4609' (-1208)
Heebner	4168' (- 767)	Ft. Scott	4643' (-1242)
Toronto	4196' (- 795)	Chero. Sh.	4672' (-1271)
Lansing	4215' (- 814)		

STATE OF KANSAS )  
 ) SS  
 COUNTY OF SEDGWICK )

Jack L. Partridge, Vice President of Abercrombie Drilling, Inc. does hereby state that the above and foregoing is a true and correct copy of the log of the GLENN ARGABRIGHT #1, 660 FNL 660 FWL Se/4, Thomas County, Kansas.

ABERCROMBIE DRILLING, INC.

BY: Jack L. Partridge  
 Jack L. Partridge, Vice Pres.

Subscribed and sworn to before me, a Notary Public, in and for the aforesaid county and state, as of this 14th day of October, 1981.

Elizabeth G. Terry  
 Elizabeth G. Terry  
 NOTARY PUBLIC

my commission expires 7-13-85

Received:  
 10/14/1981

