

CARD MUST BE TYPED

State of Kansas

CARD MUST BE SIGNED

# NOTICE OF INTENTION TO DRILL

(see rules on reverse side)

Expected Spud Date..... 6/29/87  
month day year

API Number 15- 179-20,895-00-00

OPERATOR: License # 5474  
Name Northern Lights Oil Co.  
Address 212 N. Market, Suite 400  
City/State/Zip Wichita, Kansas 67202  
Contact Person John W. Sutherland, Jr.  
Phone (316) 263-1008

SW. SW. NE. Sec. 1 Twp. 7 S, Rg. 26  East  
 West  
2970 Ft. from South Line of Section  
2310 Ft. from East Line of Section

(Note: Locate well on Section Plat on reverse side)

CONTRACTOR: License # 4958  
Name Mallard J.V., Inc.  
City/State McPherson, Kansas 67460

Nearest lease or unit boundary line 330 feet  
County Sheridan  
Lease Name Scott Well # 1

Well Drilled For: Well Class: Type Equipment:  
 Oil  Storage  Infield  Mud Rotary  
 Gas  Inj  Pool Ext.  Air Rotary  
 OWWO  Expl  Wildcat  Cable

Ground surface elevation ? feet MSL  
Domestic well within 330 feet:  yes  no  
Municipal well within one mile:  yes  no

If OWWO: old well info as follows:  
Operator  
Well Name  
Comp Date Old Total Depth

Depth to bottom of fresh water. 200-250  
Depth to bottom of usable water 1500  
Surface pipe by Alternate: 1  2  
Surface pipe planned to be set 300 ft.  
Conductor pipe required 0 ft.  
Projected Total Depth 3900 feet  
Formation Lansing/Kansas City

I certify that well will comply with K.S.A. 55-101, et seq., plus eventually plugging hole to KCC specifications.  
Date 5/29/87 Signature of Operator or Agent John W. Sutherland Title General Partner

For KCC Use:  
Conductor Pipe Required \_\_\_\_\_ feet; Minimum Surface Pipe Required \_\_\_\_\_ feet per Alt. 275  
This Authorization Expires 12-1-87 Approved By 6-1-87


*John W. Sutherland*  
*John W. Sutherland*

Must be filed with the K.C.C. five (5) days prior to commencing well  
 This card void if drilling not started within six (6) months of date received by K.C.C.

**Important procedures to follow:**

- I. Notify District office before setting surface casing.
2. Set surface casing by circulating cement to the top.
3. File completion forms ACO-1 with K.C.C. within 120 days of well spud date, following instructions on ACO-1, side 1, and including copies of wireline logs.
4. Notify District office 48 hours prior to old well workover or re-entry.
5. Prior to filing Intent, prepare a proposed plugging plan in case well is D & A, then obtain approval of plan when calling district office prior to setting surface pipe.
6. Submit plugging report (CP-4) to K.C.C. after plugging is completed.
7. Obtain an approved injection docket number before disposing of salt water.
8. Notify K.C.C. within 10 days when injection commences or terminates.

**A Regular Section of Land**  
 1 Mile = 5,280 Ft.

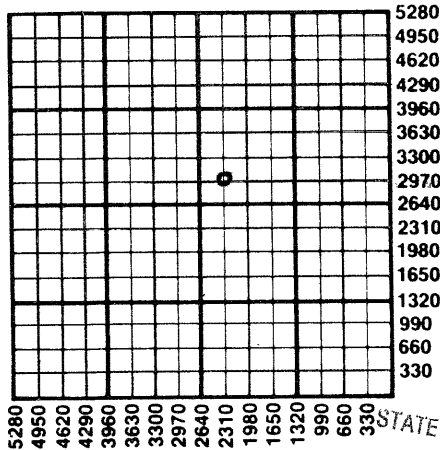

If an alternate 2 completion, cement in the production pipe from below any usable water to surface within 120 days of spud date.

RECEIVED  
 STATE CORPORATION COMMISSION

JUN - 1 1987  
 6-1-87  
 CONSERVATION DIVISION  
 Wichita, Kansas

State Corporation Commission of Kansas  
 Conservation Division  
 200 Colorado Derby Building  
 Wichita, Kansas 67202-1212  
 (316) 263-3238