


STATE OF KANSAS
STATE CORPORATION COMMISSION

Give All Information Completely
Make Required Affidavit
Mail or Deliver Report to:
Conservation Division
State Corporation Commission
211 No. Broadway
Wichita, Kansas

WELL PLUGGING RECORD

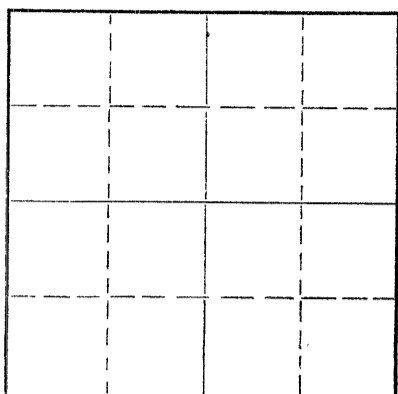

Locate well correctly on above
Section Plat

SHERIDAN County. Sec. 35 Twp. 7 Rge. 28 *(E)* (W)
Location as "NE/CNW/SW" or footage from lines _____
Lease Owner EMPIRE DRILLING COMPANY
Lease Name C. E. STEWART Well No. 1
Office Address 400 BROWN BUILDING WICHITA, KANSAS
Character of Well (completed as Oil, Gas or Dry Hole) DRY HOLE
Date well completed 5-30-57 19____
Application for plugging filed 5-30-57 19____
Application for plugging approved 5-30-57 19____
Plugging commenced 5-30-57 19____
Plugging completed 5-30-57 19____
Reason for abandonment of well or producing formation DRY HOLE

If a producing well is abandoned, date of last production 19____
Was permission obtained from the Conservation Division or its agents before plugging was commenced? YES

Name of Conservation Agent who supervised plugging of this well ELDON PETTY
Producing formation _____ Depth to top _____ Bottom _____ Total Depth of Well 4540 Feet
Show depth and thickness of all water, oil and gas formations.

OIL, GAS OR WATER RECORDS

CASING RECORD

FORMATION	CONTENT	FROM	TO	SIZE	PUT IN	PULLED OUT
SURFACE		0	275	8 5/8	275	0

Describe in detail the manner in which the well was plugged, indicating where the mud fluid was placed and the method or methods used in introducing it into the hole. If cement or other plugs were used, state the character of same and depth placed, from _____ feet to _____ feet for each plug set.

BOTTOM PLUG @ 270' 1/2 SACK HULLS, 20 SACKS CEMENT. TOP PLUG 40' 1/2 SACK HULLS, 10 SACKS CEMENT.

RECEIVED
STATE CORPORATION COMMISSION
JUN 6 1957

(If additional description is necessary, use BACK of this sheet)
Name of Plugging Contractor EMPIRE DRILLING COMPANY
Address 400 BROWN BUILDING WICHITA, KANSAS

STATE OF KANSAS, COUNTY OF SEDGWICK, ss.
I, DAN J. KORNFELD (employee of owner) or (owner or operator) of the above-described well, being first duly sworn on oath, says: That I have knowledge of the facts, statements, and matters herein contained and the log of the above-described well as filed and that the same are true and correct. So help me God.
EMPIRE DRILLING COMPANY
(Signature) DAN J. KORNFELD
400 BROWN BUILDING WICHITA, KANSAS (Address)

SUBSCRIBED AND SWORN TO before me this 5TH day of JUNE 19 57
HAZEL PIERSON Notary Public.

My commission expires JULY 2, 1958

PLUGGING
SEC 35 T 7 R 28W
BOOK PAGE 16 LINE 44

LOG

COMPANY: EMPIRE DRILLING COMPANY, WICHITA, KANSAS

CONTRACTOR: EMPIRE DRILLING COMPANY, WICHITA, KANSAS

FARM: C. E. STEWART NO 1

LOCATION: SE SE NE SEC. 35-7-28W SHERIDAN COUNTY, KANSAS

COMMENCED: MAY 18, 1957
 COMPLETED: MAY 30, 1957

ELEVATION: 2744 KB

0	TO	286	CLAY, SAND, SHELLS
286	TO	860	SHALE
860	TO	2458	SHALE AND SHELLS
2458	TO	2492	ANHYDRITE
2492	TO	2650	SHALE AND SHELLS
2650	TO	3175	SHALE AND LIME
3175	TO	3220	LIME AND SHALE
3220	TO	3365	SHALE AND LIME
3365	TO	3415	LIME AND SHALE
3415	TO	3555	SHALE AND LIME
3555	TO	3650	LIME AND SHALE
3650	TO	3800	SHALE AND LIME
3800	TO	3880	LIME AND SHALE
3880	TO	4134	LIME
4134	TO	4195	LIME AND SHALE
4195	TO	4330	SHALE AND LIME
4330	TO	4496	SHALE
4496	TO	4540	LIME
		4540	RTD--DA

RANG 8 5/8" 275' WITH 175 SACKS OF CEMENT

TOPS:

TOPEKA	3700
HEEBNER	3887
TORONTO	3913
LANSING KC	3932
BASE KC	4153
CHEROKEE	4362
BASAL PENNSYLVANIAN	
SHALEY CONGLOMERATE	4469
MISSISSIPPIAN	4480

I, DAN J. KORNFIELD, DO HEREBY CERTIFY THAT THE ABOVE AND FOREGOING IS A TRUE AND CORRECT COPY OF THE LOG ON THE STEWART NO. 1 SE SE NE OF SEC. 35-7-28, SHERIDAN COUNTY, KANSAS AS REFLECTED BY THE FILES OF THE EMPIRE DRILLING COMPANY.

Dan J. Kornfeld
 DAN J. KORNFIELD

SUBSCRIBED AND SWORN TO BEFORE ME, A NOTARY PUBLIC WITHIN AND FOR SEDGWICK COUNTY, KANSAS, THIS 5TH DAY OF JUNE, 1957

Hazel Pierson
 HAZEL PIERSON, NOTARY PUBLIC

MY COMMISSION EXPIRES JULY 2, 1958

RECEIVED
 STATE CORPORATION COMMISSION
 JUN 6 1957
 CONSERVATION DIVISION
 Wichita, Kansas

PLUGGING
 SEC. 35 T. 7 28W
 BOOK PAGE 16 LINE 44