


STATE OF KANSAS
STATE CORPORATION COMMISSION

Give All Information Completely
Make Required Affidavit
Mail or Deliver Report to:
Conservation Division
State Corporation Commission
800 Bitting Building
Wichita, Kansas

WELL PLUGGING RECORD

NORTH

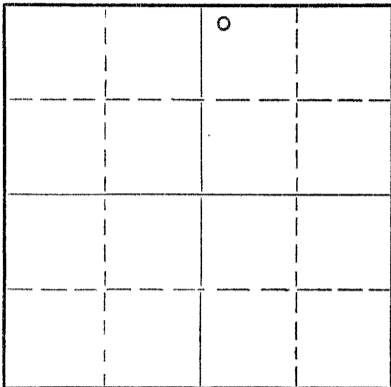

Locate well correctly on above
Section Plat

Sheridan County, Sec. 4 Twp. 7 Rge. (E) 29 (W)

Location as "NE/CNW%SW%" or footage from lines NW NW NE
Lease Owner Graham-Messman-Rinehart Oil Company
Lease Name Emigh Well No. 1
Office Address 1005 E. Second Street
Character of Well (completed as Oil, Gas or Dry Hole) Dry Hole
Date well completed July 1, 19 53
Application for plugging filed July 1, 19 53
Application for plugging approved July 1, 19 53
Plugging commenced July 7, 19 53
Plugging completed July 7, 19 53
Reason for abandonment of well or producing formation Dry

If a producing well is abandoned, date of last production 19
Was permission obtained from the Conservation Division or its agents before plugging was commenced? yes

Name of Conservation Agent who supervised plugging of this well Mr. Eldon Petty, Box 326, Hays, Ks.
Producing formation Depth to top Bottom Total Depth of Well 4188 Feet
Show depth and thickness of all water, oil and gas formations.

OIL, GAS OR WATER RECORDS

CASING RECORD

FORMATION	CONTENT	FROM	TO	SIZE	PUT IN	PULLED OUT
				8 5/8"	280'	none
				5 1/2"	4157'	3850'

Describe in detail the manner in which the well was plugged, indicating where the mud fluid was placed and the method or methods used in introducing it into the hole. If cement or other plugs were used, state the character of same and depth placed, from feet to feet for each plug set.

Filled hole with sand to 3590 ft. and dumped 4 sx. cement. Mud to 280 ft. Rock bridge set at 280 ft. and dumped 15 sx. cement. Mud to 75 ft. Rock bridge set at 75 ft. and dumped 10 sx. cement. Mud to surface.

(If additional description is necessary, use BACK of this sheet)

Name of Plugging Contractor Graham-Messman-Rinehart Oil Company
Address 1005 E. Second St., Wichita, Kansas

STATE OF Kansas, COUNTY OF Sedgwick, ss.
J. A. Gilliland (employee of owner) or (owner or operator) of the above-described well, being first duly sworn on oath, says: That I have knowledge of the facts, statements, and matters herein contained and the log of the above-described well as filed and that the same are true and correct. So help me God.

(Signature) J. A. Gilliland
1005 E. Second St., Wichita, Ks.
(Address)

SUBSCRIBED AND SWORN TO before me this 8th day of July, 19 53

My commission expires December 1, 1956

Barbara J. Scott
Notary Public.

PLUGGING
FILE SEC 4 T 7 R 29W
BOOK PAGE 111 LINE 41

JUL 17, 1953