


STATE OF KANSAS
STATE CORPORATION COMMISSION

Give All Information Completely
Make Required Affidavit
Mail or Deliver Report to:
Conservation Division
State Corporation Commission
800 Bitting Building
Wichita, Kansas

WELL PLUGGING RECORD

Location as "NE/CNW/SW" or footage from lines SE Corner
County. Sec. 18 Twp. 7 Rge. 29 (E) W (W)

NORTH

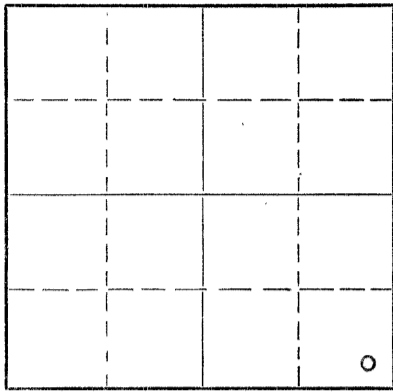

Locate well correctly on above
Section Plat

Lease Owner Nadel and Gussman
Lease Name Pope Well No. 1
Office Address Box 309, Tulsa, Oklahoma
Character of Well (completed as Oil, Gas or Dry Hole) Dry
Date well completed 1-17-53
Application for plugging filed 1-17-53
Application for plugging approved 1-17-53
Plugging commenced 1-17-53
Plugging completed 1-17-53
Reason for abandonment of well or producing formation Dry

If a producing well is abandoned, date of last production 19
Was permission obtained from the Conservation Division or its agents before plugging was commenced? Yes

Name of Conservation Agent who supervised plugging of this well Eldon Petty
Producing formation _____ Depth to top _____ Bottom _____ Total Depth of Well 4610 Feet
Show depth and thickness of all water, oil and gas formations.

OIL, GAS OR WATER RECORDS

CASING RECORD

FORMATION	CONTENT	FROM	TO	SIZE	PUT IN	PULLED OUT
				8-5/8"	305	0-

Describe in detail the manner in which the well was plugged, indicating where the mud fluid was placed and the method or methods used in introducing it into the hole. If cement or other plugs were used, state the character of same and depth placed, from _____ feet to _____ feet for each plug set.

Hole filled with heavy mud from 4610 to 210' - set plug with 15 sacks cement; filled hole with mud to 45' - set plug with 10 sacks cement.

RECEIVED
STATE CORPORATION COMMISSION
JAN 30 1953
CONSERVATION DIVISION

(If additional description is necessary, use BACK of this sheet)
Name of Plugging Contractor Reserve Drilling Company, Inc.
Address 703 Union National Bank Building, Wichita 2, Kansas

STATE OF KANSAS, COUNTY OF SEDGWICK, ss.
L. C. Hay (employee of owner) ~~Sworn or Operator~~ of the above-described well, being first duly sworn on oath, says: That I have knowledge of the facts, statements, and matters herein contained and the log of the above-described well as filed and that the same are true and correct. So help me God.

(Signature) L. C. Hay
703 Union National Bank Bldg. Wichita
(Address)

SUBSCRIBED AND SWORN TO before me this 20th day of January 1953
Rola Bantz Notary Public.

My commission expires Nov. 3, 1956

PLUGGING
FILE SEC 18 T 7 R 290
BOOK PAGE 25 LINE 16

WELL LOG

NADEL AND GUSSMAN

POPE No. 1

SE SE SE 18-7-29W
Sheridan County, Kansas

Comm: 1- 3-53
Comp: 1-17-53

Casing: 8-5/8" 305' w/150 Sax

Formations	Depth
Shale	30
Gray Shale	70
Sand	258
Blue Shale	307
Shale	380
Shale and shells	1460
Sand	1640
Shale, shells and sand	2060
Shale and shells	2170
Shale, shells and red bed	2530
Red beds	2569
Anhydrite	2605
Shale	2655
Shale and shells	2820
Lime, shale and red bed	2945
Lime and shale	3290
Shale	3350
Lime and shale	3965
Lime	4263
Lime and shale	4526
Shale and chert	4565
Chert	4610

Geological Tops

Topeka	3642
Heebner	3956
Toronto	3977
Lans-Kansas City	3993
Base Kansas City	4226
Miss. Chert	4545
Miss. Lime	4596
F.D.	4610

STATE OF KANSAS)
COUNTY OF SEDGWICK) SS:


L. C. Hay, of lawful age, deposes and states that the above formations and tops are correct as shown by the daily drilling log of the Pope No. 1 Test in the SE SE SE 18-7-29W, Sheridan County, Kansas.

Subscribed and sworn to before me this 20th day of January, 1953.

R. C. Hay

Notary Public

My commission expires Nov. 3, 1956

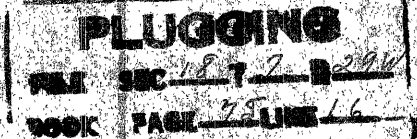

1/30/53