


STATE OF KANSAS
STATE CORPORATION COMMISSION

WELL PLUGGING RECORD

Give All Information Completely
Make Required Affidavit
Mail or Deliver Report to:
Conservation Division
State Corporation Commission
800 Bitting Building
Wichita, Kansas

Thomas County. Sec. 30 Twp. 7 Rge. 32W (E) (W)
Location as "NE/CNW 1/4 SW 1/4" or footage from lines NE NE NW
Lease Owner KELLY - WEISSBECK
Lease Name Pansy Thomas Well No. 1
Office Address Wakeeney, Kansas
Character of Well (completed as Oil, Gas or Dry Hole) Dry
Date well completed 5/23/50 19
Application for plugging filed 5/23/50 19
Application for plugging approved 5/23/50 19
Plugging commenced 5/24/50 19
Plugging completed 5/24/50 19
Reason for abandonment of well or producing formation Dry in all formations

NORTH

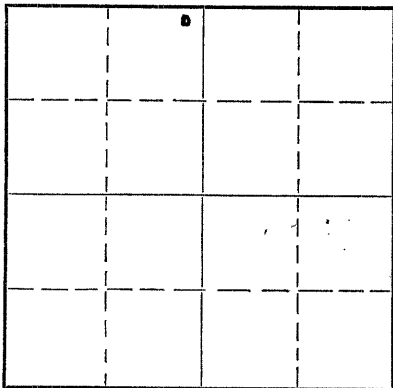

Locate well correctly on above
Section Plat

If a producing well is abandoned, date of last production 19
Was permission obtained from the Conservation Division or its agents before plugging was commenced? Yes

Name of Conservation Agent who supervised plugging of this well E. R. Petty
Producing formation None Depth to top Bottom Total Depth of Well 5264 Feet
Show depth and thickness of all water, oil and gas formations.

OIL, GAS OR WATER RECORDS

CASING RECORD

Formation	Content	From	To	Size	Put In	Pulled Out
						None

Describe in detail the manner in which the well was plugged, indicating where the mud fluid was placed and the method or methods used in introducing it into the hole. If cement or other plugs were used, state the character of same and depth placed, from feet to feet for each plug set.

Filled hole with heavy mud to 265'; bridged hole at 265'; cemented with 15 sacks of cement; filled hole to 35' with mud; bridged at 35' and cemented with 10 sacks of cement to top.

RECEIVED
Conservation Div.
JUL 17 1950
STATE CORPORATION COMMISSION
KANSAS
JUL 17, 1950

(If additional description is necessary, use BACK of this sheet)

Correspondence regarding this well should be addressed to KELLY - WEISSBECK
Address Wakeeney, Kansas

STATE OF Kansas, COUNTY OF Drey, ss.
C. B. Kelly (employee of owner) or (owner or operator) of the above-described well, being first duly sworn on oath, says: That I have knowledge of the facts, statements, and matters herein contained and the log of the above-described well as filed and that the same are true and correct. So help me God.

(Signature) X C. B. Kelly
Wakeeney, Kansas
(Address)

SUBSCRIBED AND SWORN TO before me this 14th day of July, 1950

My commission expires 10/8/1951 Notary Public.

PLUGGING
FILE SEC 30 T 7 R 32W
BOOK PAGE 8 LINE 1

KELLY - WEISSBECK
Wakeeney, Kansas

Pansy Thomas No. 1

NE NE NW Sec. 30-7-32W
Thomas County, Kansas

Commenced R. D.: 4/29/50
Completed R. D.: 5/24/50
Total Depth: 5264'

Elevation: 3021'
Initial Prod:
Contractor: S. A. Berwick
Drilling Co.

Casing: 270' 8 5/8" 8rd thd.

Strata	Depth
Surface Clay and Sand	0 - 135
Sand and Shells	135 - 275
Shale	275 - 1550
Sand and Lime	1550 - 1600
Shale	1600 - 2180
Sandy Shale	2180 - 2260
Shale and Lime	2260 - 2475
Redbed and Shale	2475 - 2785
Anhydrite	2785 - 2815
Shale and Shells	2815 - 3090
Shale and Lime	3090 - 3160
Redbed and Shells	3160 - 3320
Shale and Lime	3320 - 3740
Lime	3740 - 4010
Shale and Lime	4010 - 4105
Lime	4105 - 4238
Lime and Chert	4238 - 4250
Lime	4250 - 4415
Lime and Shale	4415 - 4720
Lime	4720 - 4754
Lime and Shale	4754 - 4795
Lime and Chert	4795 - 4860
Lime	4860 - 5250
Lime and Granite	5250 - 5264

I here by certify that the above is a true and correct log of said well as reflected by the daily drilling reports.

S. A. BERWICK DRILLING CO.

By

S. A. Berwick
S. A. Berwick Owner

Signed and sworn to in my presence this 10th day of July, 1950, by S. A. Berwick, Owner of the S. A. BERWICK DRILLING CO. a sole proprietor in the State of Kansas.

Deeter H. Miller
RECEIVED Notary Public

My Commission Expires: September 29, 1951

Conservation

JUL 17 1950 JUL 17, 1950

STATE CORPORATION
COMMISSION
KANSAS

