


STATE OF KANSAS  
STATE CORPORATION COMMISSION

Give All Information Completely  
Make Required Affidavit  
Mail or Deliver Report to:  
Conservation Division  
State Corporation Commission  
800 Bittig Building  
Wichita, Kansas

WELL PLUGGING RECORD

NORTH

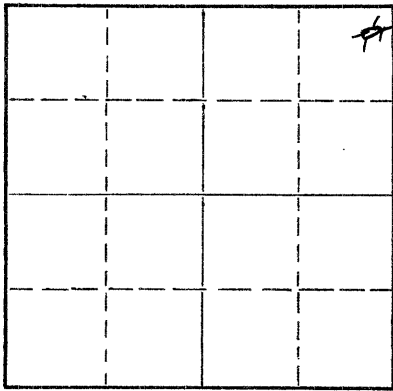

Locate well correctly on above  
Section Plat

Thomas County, Sec. 12 Twp. 7 Rge. 33 (E) (W)  
Location as "NE/CNW/SW" or footage from lines NE NE NE/4  
Lease Owner Virginia Drilling Co Inc  
Lease Name Cooper Well No. 1  
Office Address 712 Brown Bldg-Wichita 2, Kansas  
Character of Well (completed as Oil, Gas or Dry Hole) dry hole  
Date well completed 9-1-56 19  
Application for plugging filed 8-31-56 19  
Application for plugging approved 8-31-56 19  
Plugging commenced 9-1-56 19  
Plugging completed 9-1-56 19  
Reason for abandonment of well or producing formation

If a producing well is abandoned, date of last production 19  
Was permission obtained from the Conservation Division or its agents before plugging was commenced? yes

Name of Conservation Agent who supervised plugging of this well Milton Galyardt  
Producing formation Depth to top Bottom Total Depth of Well 4695 Feet  
Show depth and thickness of all water, oil and gas formations.

OIL, GAS OR WATER RECORDS

CASING RECORD

FORMATION	CONTENT	FROM	TO	SIZE	PUT IN	PULLED OUT
		0	309	8 5/8"	324	none

Describe in detail the manner in which the well was plugged, indicating where the mud fluid was placed and the method or methods used in introducing it into the hole. If cement or other plugs were used, state the character of same and depth placed, from feet to feet for each plug set.

Mudded to 290 ft. - set plug w/ 15 sx cement 1/2 sx hulls

Mudded to 40 ft. - set plug w/ 10 sx cement 1/2 sx hulls

(If additional description is necessary, use BACK of this sheet)

Name of Plugging Contractor Virginia Drilling Co Inc.  
Address 712 Brown Bldg.-Wichita 2, Kansas

STATE OF Kansas, COUNTY OF Sedgwick, ss. S. A. Murphy

(employee of owner) or (owner or operator) of the above-described well, being first duly sworn on oath, says: That I have knowledge of the facts, statements, and matters herein contained and the log of the above-described well as filed and that the same are true and correct. So help me God.

(Signature) S. A. Murphy  
712 Brown Bldg. Wichita 2, Kansas  
(Address)

SUBSCRIBED AND SWORN to before me this 12<sup>th</sup> day of September, 1956

Muske Hawkins  
Notary Public.

My commission expires February 5, 1957.

PLUGGING  
FILE SEC. 12 T. 7 R. 33w  
BOOK PAGE 96 LINE 4

Sep 13, 1956

COOPER #1 - NE NE NE/4 Section 12-7-33 Thomas County, Kansas  
 Company - Virginia Drilling Co. Inc.  
 Contractor - same  
 Commenced - August 17, 1956  
 Completed - September 1, 1956  
 Elevation 3087 DF  
 Total Depth - 4695  
 8 5/8" set at 309 ft.  
 Dry hole.

FORMATION	DEPTH	
Surface clay-sand-shale-shells	0- 309	
Shale	309- 880	
Shale-shells	880-1630	
Shale-sand-shells	1630-1985	
Shale-sand-lime shells	1985-2085	TOPS:
Shale-shells-sand streaks	2085-2270	3780 - Topeka
Shale-shells	2270-2310	3990 - Douglass
Shale-shells-sand	2310-2395	4046 - K.C.
Anhydrite	2395-2425	4315 - Marmaton
Red bed-shale-shells	2425-2490	4540 - Cherokee
Lime	2490-2500	4645 - Mississippi
Shale-shells-red bed-	2500-2720	
Shale-lime	2720-3370	
Lime	3370-3515	
Lime-shale	3515-3665	
Lime-chalky shale	3665-3740	
Lime	3740-3895	
Lime@shale	3895-3970	
Lime	3970-4045	
Lime-shale	4045-4110	
Lime	4110-4305	
Lime@shale	4305-4435	
Lime	4435-4695 T.D.	

*S. A. Murphy*  
 S. A. Murphy

Subscribed and sworn to before me, a Notary Public, this  
12th day of September, 1956.

*Wanda Jackson*  
 Notary Public

My commission expires: February 5, 1956.

PLUGGING  
 FILE SEC 12 T 7 R33W  
 BOOK PAGE 96 1 of 4

SEP 13, 1956