

STATE OF KANSAS
STATE CORPORATION COMMISSION

WELL PLUGGING RECORD

Give All Information Completely
Make Required Affidavit
Mail or Deliver Report to
Conservation Division
State Corporation Comm.
245 North Water
Wichita, KS 67202

Sherman County, Sec. 6 Twp. 7S Rge. 40 XX/W
Location as "NE/CNW $\frac{1}{4}$ SW $\frac{1}{4}$ " or footage from lines
C SW/4 SE/4

Lease Owner Shepler & Thomas, Inc.

Lease Name Roeder Well No. 1

Office Address P.O. Box 2164 Evergreen, Co. 80439

Character of Well (Completed as Oil, Gas or Dry Hole)
Dry Hole

Date Well completed December 8 1980

Application for plugging filed Verbal 12-8 1980

Application for plugging approved Same 1980

Plugging commenced 12-8 1980

Plugging completed 12-8 1980

Reason for abandonment of well or producing formation
Dry Hole


If a producing well is abandoned, date of last production
1980

Was permission obtained from the Conservation Division or
its agents before plugging was commenced? Yes

Name of Conservation Agent who supervised plugging of this well Gilbert Balthazar

Producing formation Niobrara Depth to top 1550 Bottom 1580 Total Depth of Well 1608

Show depth and thickness of all water, oil and gas formations.

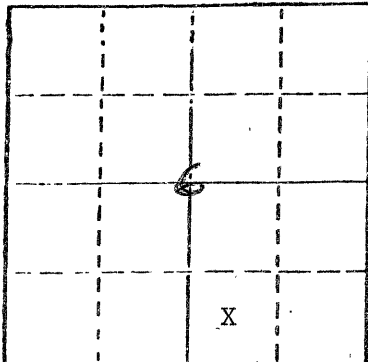

Locate well correctly on above
Section Plat

OIL, GAS OR WATER RECORDS

CASING RECORD

FORMATION	CONTENT	FROM	TO	SIZE	PUT IN	PULLED OUT
Niobrara	Water	1550	1580		None	
Water Sand	Water	120	350	7"	383	None

Describe in detail the manner in which the well was plugged, indicating where the mud fluid was placed and the method or methods used in introducing it into the hold. If cement or other plugs were used, state the character of same and depth placed, from _____ feet to _____ feet for each plug set.

- 40 SX From 1600-1400'
- 30 SX From 360-500'
- 10 SX From 40' to surface
- A rubber plug set at 40' w/hulls

RECEIVED
DIVISION
FEB - 4 1981
FEB - 4 1981

(If additional description is necessary, use BACK of this sheet)

Name of Plugging Contractor _____

STATE OF Colorado COUNTY OF Jefferson, ss.
Allen N. Thomas (employee of owner) or (owner or operator)
of the above-described well, being first duly sworn on oath, says: That I have knowledge of the facts, statements, and matters herein contained and the log of the above-described well as filed and that the same are true and correct. So help me God.

(Signature) Allen N. Thomas
P.O. Box 2164 Evergreen, Colorado 80439
(Address)

SUBSCRIBED AND SWORN TO before me this 2nd day of February, 1981

Genevieve S. Cavanaugh
Notary Public.

My commission expires 9-9-84