


Give All Information Completely
Make Required Affidavit
Mail or Deliver Report to:
Conservation Division
State Corporation Commission
212 No. Market
Wichita, Kansas

WELL PLUGGING RECORD

NORTH

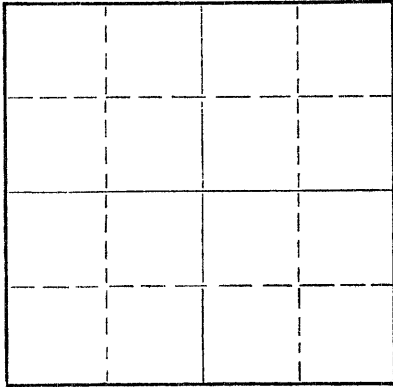

Locate well correctly on above
Section Plat

Sherman County. Sec. 13 Twp. 7S Rge. 40W (E) (W)
Location as "NE/CNW/SW" or footage from lines C NE SE
Lease Owner G. Ray Carnahan
Lease Name Rhoads Well No. 1
Office Address 1700 Wichita Plaza, Wichita, Kansas 67202
Character of Well (completed as Oil, Gas or Dry Hole) D&A
Date well completed 8/26 1969
Application for plugging filed 8/26 1969
Application for plugging approved 8/26 1969
Plugging commenced 8/26 1969
Plugging completed 8/26 1969
Reason for abandonment of well or producing formation D&A

If a producing well is abandoned, date of last production 19
Was permission obtained from the Conservation Division or its agents before plugging was commenced? yes

Name of Conservation Agent who supervised plugging of this well
Producing formation Depth to top Bottom Total Depth of Well 4450 Feet
Show depth and thickness of all water, oil and gas formations.

OIL, GAS OR WATER RECORDS

CASING RECORD

FORMATION	CONTENT	FROM	TO	SIZE	PUT IN	PULLED OUT

Describe in detail the manner in which the well was plugged, indicating where the mud fluid was placed and the method or methods used in introducing it into the hole. If cement or other plugs were used, state the character of same and depth placed, from feet to feet for each plug set.

1st plug @ 2075 w/ 70 sxs.
2nd plug @ 360 w/ 20 sxs.
3rd plug @ 40 w/ 10 sxs.

RECEIVED
STATE CORPORATION COMMISSION
SEP 11 1969
CONSERVATION DIVISION
Wichita, Kansas

(If additional description is necessary, use BACK of this sheet)

Name of Plugging Contractor Murfin Drilling Company
Address 617 Union Center, Wichita, Kansas 67202

STATE OF Kansas, COUNTY OF Sedgwick, ss.
James R. Daniels (employee of owner) or (owner or operator) of the above-described

well, being first duly sworn on oath, says: That I have knowledge of the facts, statements, and matters herein contained and the log of the above-described well as filed and that the same are true and correct. So help me God.

(Signature) James R Daniels
617 Union Center, Wichita, Kansas
(Address)

SUBSCRIBED AND SWORN TO before me this 10th day of September, 1969

SANDRA S. HOLZMAN, Notary Public
My commission expires March 4, 1972

Sandra S. Holzman
Notary Public.

WELL LOG

COMPANY G. Ray Carnahan

SEC. 13 T. 7S R. 40W
LOG. C NE SE

FARM Rhoads

NO. 1


RIG. NO. 14

TOTAL DEPTH 4450'

COMM. 8/18/69

COMP. 8/26/69

COUNTRY Sherman
KANSAS

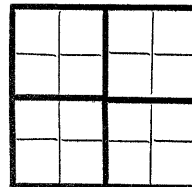

SHOT OR TREATED

CONTRACTOR Murfin Drilling Company

ISSUED

CASING

20	10
15	8 5/8" 383'/300 sxs.
12	6
13	5

ELEVATION

PRODUCTION D&A

FIGURES INDICATE BOTTOM OF FORMATIONS

103	Sands
220	Sand
240	Clay
360	Sand
390	Shale
1230	Shell-clay
2170	Shale
2470	Shale-shells
2625	Lime & shale
2720	Shale
3030	Lime-shale
3305	Lime
3485	Lime-shale
3700	Lime
3785	Lime & shale
3900	Shale-lime
4000	Lime
4060	Lime
4120	Lime-shale
4226	Lime w/shale
4355	Lime
4450	LIME

RECEIVED
STATE CORPORATION COMMISSION
SEP 11 1969
CONSERVATION DIVISION
Wichita, Kansas

State of Kansas)
County of Sedgwick) ss:

I, James R. Daniels of the Murfin Drilling Company

upon oath state that the above and foregoing is a true and correct copy of the log of the Rhoads #1 well.

James R. Daniels

Subscribed and sworn to before me this 10th day of Sept. 19 69

SANDRA S. HOLZMAN, Notary Public
My Commission Expires: My commission expires March 4, 1972

Sandra S. Holzman
NOTARY PUBLIC