


STATE OF KANSAS
STATE CORPORATION COMMISSION

Give All Information Completely
Make Required Affidavit
Mail or Deliver Report to:
Conservation Division
State Corporation Commission
211 No. Broadway
Wichita, Kansas

15-141-00054-00-00

WELL PLUGGING RECORD

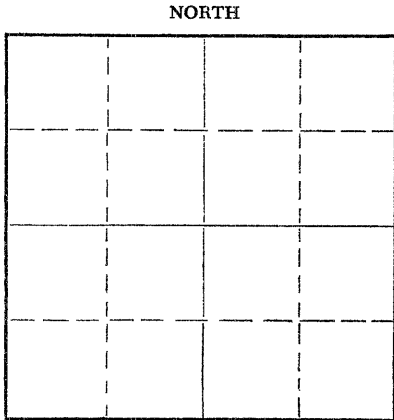

Locate well correctly on above
Section Plat

Osborne County. Sec. 14 Twp. 8 Rge. 14 (E) 14 (W)
Location as "NE/CNW/SW" or footage from lines SW SW NW
Lease Owner Cities Service Oil Co.
Lease Name Bales Well No. 1
Office Address Bartlesville, Okla.
Character of Well (completed as Oil, Gas or Dry Hole) Dry Hole
Date well completed 4/23 19 58
Application for plugging filed 4/24 19 58
Application for plugging approved 4/28 19 58
Plugging commenced 4/23 19 58
Plugging completed 4/23 19 58
Reason for abandonment of well or producing formation _____

If a producing well is abandoned, date of last production _____ 19 _____
Was permission obtained from the Conservation Division or its agents before plugging was commenced? Yes

Name of Conservation Agent who supervised plugging of this well Mr. Donald Truan
Producing formation _____ Depth to top _____ Bottom _____ Total Depth of Well 3844' Feet
Show depth and thickness of all water, oil and gas formations.

OIL, GAS OR WATER RECORDS

CASING RECORD

FORMATION	CONTENT	FROM	TO	SIZE	PUT IN	PULLED OUT
				8 5/8"	240'	None

Describe in detail the manner in which the well was plugged, indicating where the mud fluid was placed and the method or methods used in introducing it into the hole. If cement or other plugs were used, state the character of same and depth placed, from _____ feet to _____ feet for each plug set.

Filled hole with heavy mud with drill pipe to 235'. Pushed Halliburton wooden bridge plug to 235'. Dumped 1/3 sx hulls and 20 sx cement on plug. Filled hole to 40' of surface with heavy mud. Pushed Halliburton wooden plug to 40', dumped 1/3 sx hull&10 sx cement, filled hole to surface with cement.


(If additional description is necessary, use BACK of this sheet)
Name of Plugging Contractor Lohmann & Johnson S-7-58
Address Evansville, Indiana

STATE OF Kansas, COUNTY OF Barton, ss.
M.M. Hardin (employee of owner) or (owner or operator) of the above-described well, being first duly sworn on oath, says: That I have knowledge of the facts, statements, and matters herein contained and the log of the above-described well as filed and that the same are true and correct. So help me God.

(Signature) M.M. Hardin
Box 553, Russell, Kansas (Address)

SUBSCRIBED AND SWORN TO before me this 6th day of May 19 58
W. G. Smith

My commission expires March 12, 1959 Notary Public.

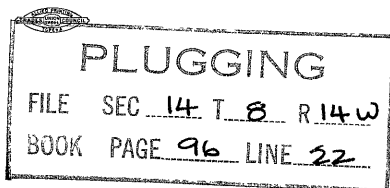

WELL RECORD

15-141-00094-00-00

WILDCAT.....

DISCOVERY.....

POOL.....

COMPANY Cities Service Oil Company WELL # 1 FARM Rales

LOCATION 455' North and 330' East of W/4 Corner

Section 14, Township 8, Range 14 W

ELEV. 1891 (1798 Gr.) CO. Osborne STATE Kansas

IP. Dry Hole. P. & A. 4-23-58

PERFS.

FRAC. ACID

T.D. 3847' PBTD. GRAV/GOR.

DRLG. COMM. April 6, 1958 COMP. April 23, 1958 CONTRACTOR Lohmann-Johnson Eng'g., Co. Inc.

CASING RECORD:

8-5/8" at 240' with 175 sacks cement.

FORMATION RECORD:

shale	0-1030
anhydrite	1065
shale	1090
shale and shells	1530
shale and lime	1780
lime and shale	1925
lime	2518
shale and lime	2605
lime and shale	2788
lime	3500
shale	3535
lime	3847 T.D.

Topoka	2731
Rechner	2974
Dodge	2997
Lansing	3022
Base Kansas City	3337
Cherty Conglomerate	3527
Viola	3584
Simpson	3716
Arbuckle	3768
Fen.	79'
T.D.	3847

D.S.T. 1768-80, open 1 hour, recovered 10' mud; B.H.P. 515# in 30 minutes.

D.S.T. 3073-95, open 1 hour, recovered 12' mud; B.H.P. 155# in 30 minutes.

D.S.T. 3467-3500, open 1 hour, recovered 20' mud; B.H.P. 780# in 30 minutes.

D.S.T. 3646-95, open 1 hour, recovered 20' mud; B.H.P. 710# in 30 minutes.

Slope Tests (Sylfo):

500'	-	0°
1000'	-	0°
1500'	-	0°
2000'	-	0°
2500'	-	0°
3500'	-	0°

5-7-58

PLUGGING

WELL SEC 14 T 8 R 14W

PAGE 96 LINE 22

7-7/8" Rotary hole.