

15-141-2053-00-00


STATE OF KANSAS  
STATE CORPORATION COMMISSION

WELL PLUGGING RECORD

Give All Information Completely  
Make Required Affidavit  
Mail or Deliver Report to  
Conservation Division  
State Corporation Comm.  
245 North Water  
Wichita, KS 67202

Osborne County, Sec. 14 Twp. 8S Rge. 14 E/W  
Location as "NE/CNW $\frac{1}{4}$ SW $\frac{1}{4}$ " or footage from lines  
SW SE SW

Lease Owner Petroleum Management Inc.  
Lease Name Bliss Well No. #2  
Office Address 400 N Woodlawn, Suite 201 Wichita, Ks. 67208  
Character of Well (Completed as Oil, Gas or Dry Hole)  
Dry Hole

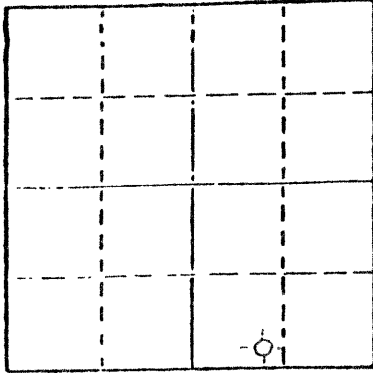

Locate well correctly on above  
Section Plat

Date Well completed November 30 19 78  
Application for plugging filed November 30 19 78  
Application for plugging approved November 30 19 78  
Plugging commenced November 22, 19 78  
Plugging completed November 30, 19 78  
Reason for abandonment of well or producing formation  
no commercial production  
If a producing well is abandoned, date of last production  
19

Was permission obtained from the Conservation Division or  
its agents before plugging was commenced? yes

Name of Conservation Agent who supervised plugging of this well Duane L. Rankin  
Producing formation \_\_\_\_\_ Depth to top \_\_\_\_\_ Bottom \_\_\_\_\_ Total Depth of Well \_\_\_\_\_  
Show depth and thickness of all water, oil and gas formations.

OIL, GAS OR WATER RECORDS

CASING RECORD

FORMATION	CONTENT	FROM	TO	SIZE	PUT IN	PULLED OUT
surface casing	common	0	198.21'	8 5/8"	198.21'	0

Describe in detail the manner in which the well was plugged, indicating where the mud fluid  
was placed and the method or methods used in introducing it into the hold. If cement or other  
plugs were used, state the character of same and depth placed, from \_\_\_\_\_ feet to  
\_\_\_\_\_ feet for each plug set.

Plug #1 @ 540' with 50 sxs  
Plug #2 @ 210' with 25 sxs  
Plug #3 # 40' with solid bridge  
2 sxs rat hole  
cemented with 50-50 poz 2% gel

12/13/78  
RECEIVED  
STATE CORPORATION COMMISSION  
DEC 13 1978  
CONSERVATION DIVISION  
Wichita, KS

(If additional description is necessary, use BACK of this sheet)

Name of Plugging Contractor Pioneer Drilling Company, Inc.  
308 West Mill Plainville, Kansas 67663

STATE OF KANSAS COUNTY OF SEDGWICK, ss.  
(employee of owner) or (owner or operator)  
of the above-described well, being first duly sworn on oath, says: That I have knowledge of  
the facts, statements, and matters herein contained and the log of the above-described well  
as filed and that the same are true and correct. So help me God.

(Signature) Dale Smith  
400 N. Woodlawn, Suite 201, Wichita, Ks.  
(Address) 67208

SUBSCRIBED AND SWORN TO before me this 12th day of December, 1978

Bonnie Brown  
Bonnie Brown - Notary Public.

My commission expires



15-141-20053-00-00  
WELL LOG

OPERATOR: Petroleum Management Inc.

WELL NAME: Bliss #2 LOCATION: SW SE SW 14-8S-14W

COUNTY: Osborne STATE: Kansas

WELL COMMENCED: November 22, 1978 WELL COMPLETED: November 30, 1978

ELEVATION: 1876' KB TOTAL DEPTH: 2840'

PRODUCTION: D & A RIG NO: #2

CASING - 8-5/8": 198.21' cemented with 115 sxs common 2% gel 3% cc

5-1/2": \_\_\_\_\_

ALL MEASUREMENTS TAKEN FROM THE TOP OF ROTARY BUSHING:

FROM	TO	FORMATION	DEVIATION FROM VERTICAL	REMARKS:
0'	206'	shale and sand	206' -	3/4 degree
206'	330'	sand and shale		
330'	1368'	shale		
1368'	1690'	shale and sand	1422' - 2	degrees
1690'	2008'	shale and lime		
2008'	2072'	shale	2008' - 1 3/4	degrees
2072'	2210'	shale and lime		
2210'	2296'	shale and lime		
2296'	2517'	shale and lime		
2517'	2586'	shale and lime		
2586'	2626'	lime		
2626'	2637'		2600' - 1	degree
2637'	2795'	lime and shale		
2795'	2840'	lime		
2840'	RTD			

RECEIVED  
STATE CORPORATION COMMISSION

DEC 13 1978

CONSERVATION DIVISION  
Wichita, Kansas

12/13/78

STATE OF KANSAS  
COUNTY OF

The undersigned hereby certifies that to the best of his knowledge and belief, the above facts are true and correct

PIONEER DRILLING CO., INC.

By

*Charles Jones*

SUBSCRIBED AND SWORN TO, BEFORE ME, This 1st day of Dec., 1978.

MY COMM. EXP. SEPT. 6, 1981.

Krystal Schwenn  
KRystal SCHWENN - NOTARY PUBLIC

