

15-141-00008-00-00

WELL PLUGGING RECORD

OR


FORMATION PLUGGING RECORD

Strike out upper line when reporting plugging of formations.

STATE OF KANSAS STATE CORPORATION COMMISSION

Give All Information Completely Make Required Affidavit Mail or Deliver Report to: Conservation Division State Corporation Commission 800 Bitting Building Wichita, Kansas

Osborne County. Sec. 15 Twp. 8 Rge. (E) 14 (W) Location as "NE 1/4 NW 1/4 SW 1/4" or footage from lines SW SE NW Lease Owner Westgate-Greenland Oil Company Lease Name Spears Well No. 2 Office Address 1022 Union National Bank Building, Wichita 2, Kansas Character of Well (completed as Oil, Gas or Dry Hole) dry hole Date well completed August 4, 1948 Application for plugging filed August 12, 1948 Application for plugging approved August 12, 1948 Plugging commenced August 18, 1948 Plugging completed August 24, 1948 Reason for abandonment of well or producing formation

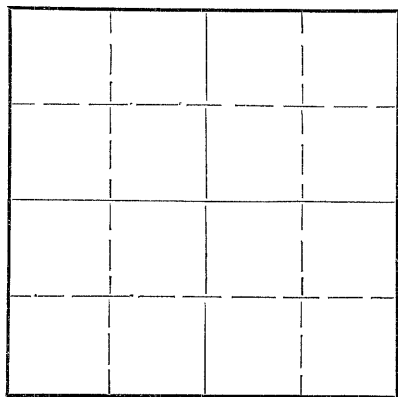

Locate well correctly on above Section Plat

Name of Conservation Agent who supervised plugging of this well M. A. Rives Producing formation Depth to top Bottom Total Depth of Well 3167 Feet Show depth and thickness of all water, oil and gas formations.

OIL, GAS OR WATER RECORDS

CASING RECORD

Table with 7 columns: Formation, Content, From, To, Size, Put In, Pulled Out. Rows include Surface and Lansing formations.

Describe in detail the manner in which the well was plugged, indicating where the mud fluid was placed and the method or methods used in introducing it into the hole. If cement or other plugs were used, state the character of same and depth placed, from feet to feet for each plug set.

Filled hole from 3167' to 3090' with crushed rock Dumped 5 sacks cement at 3090' and filled with heavy mud to 160'. Dumped in 20 sacks cement on 10' rock bridge at 160' and filled with heavy mud to 18'. Dumped in 10 sacks cement filled to cellar base.

(If additional description is necessary, use BACK of this sheet)

Correspondence regarding this well should be addressed to G. E. Bitler, c/o Westgate-Greenland Oil Company, Address 1022 Union National Bank Building, Wichita 2, Kansas


STATE OF Kansas, COUNTY OF Kan Sedgwick, ss. G. E. Bitler (employee of owner) or (owner or operator) of the above-described well, being first duly sworn on oath, says: That I have knowledge of the facts, statements, and matters herein contained and the log of the above-described well as filed and that the same are true and correct. So help me God.

(Signature) G. E. Bitler 1022 Union National Bank Building, (Address)

SUBSCRIBED AND SWORN to before me this 13th day of September, 1948

Esther Russell Notary Public.

My commission expires May 25, 1949

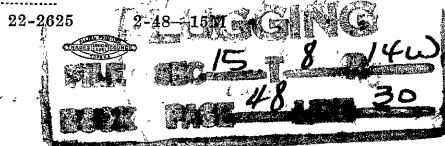

9-13-48

15-141-00008-00-00

COMPANY: Westgate Greenland Oil Company
 CONTRACTOR: Jackson Drilling Corporation
 FARM: Spears #2
 LOCATION: SW SE NW/4 Section 15-5-14
 Osborne County, Kansas
 COMMENCED: July 8, 1948
 COMPLETED: July 22, 1948 - Rotary
 August 4, 1948 - Cardwell

0	to	85	Rock & shale
85	to	163	Shale
163	to	570	Shale & shells
570	to	580	Red bed
580	to	655	Sandy Lime
655	to	665	Shale & shells
665	to	690	Black shale
690	to	730	Shell & shale
730	to	750	Broken Lime
750	to	835	Red Shale
835	to	980	Shale broken
980	to	1105	Red shale
1105	to	1130	Lime hard
1130	to	1170	Shale & shells
1170	to	1310	Shale
1310	to	1405	Red and blue shale & shells
1405	to	1490	Shale & red bed
1490	to	1580	Salt
1580	to	1717	Shale & shells
1717	to	1810	Shale & lime streaks
1810	to	1950	shale
1950	to	2155	Shale & lime
2155	to	2317	Shale & shells
2317	to	3018	Shale and Lime & Lime and shale
3018	to	3093	Lime
		3093	Rotary
		3167	Cardwell

Top Lansing 3092'

5 1/2" 14# casing @ 3092'. 60 sacks cement
 10 3/4" casing @ 160'. 150 sacks cement

CERTIFICATE

I, Clare A. Stewart, do hereby certify that the above and foregoing is a true and correct copy of log of the Spears #2, Section 15-5-14, Osborne County, Kansas, as reflected by files of the Jackson Drilling Corporation.

Clare A. Stewart
 Clare A. Stewart

Subscribed and sworn to before me, a Notary Public, within and for Johnson County, Kansas, this 13th day of August, 1948

Dorothy J. Wilson
 Dorothy J. Wilson

My Commission expires November 30, 1950

PLUGGING
 AUG 15 8 14
 1948

9-13-48