

15-141-00009-00-00

STATE OF KANSAS  
STATE CORPORATION COMMISSION

WELL PLUGGING RECORD

OR


FORMATION PLUGGING RECORD

Strike out upper line  
when reporting plug-  
ging off formations.

Give All Information Completely  
Make Required Affidavit  
Mail or Deliver Report to:  
Conservation Division  
State Corporation Commission  
800 Bitting Building  
Wichita, Kansas

Osborne County. Sec. 15 Twp. 8 Rge. (E) 14 (W)  
Location as "NE $\frac{1}{4}$ NW $\frac{1}{4}$ SW $\frac{1}{4}$ " or footage from lines NW SW SE  
Lease Owner. Westgate-Greenland Oil Company  
Lease Name. Spears Well No. 1  
Office Address. 1022 Union National Bank Building, Wichita 2, Kansas  
Character of Well (completed as Oil, Gas or Dry Hole) dry hole  
Date well completed. August 7, 1948 19  
Application for plugging filed. August 12, 1948 19  
Application for plugging approved. August 12, 1948 19  
Plugging commenced. January 21, 1949 19  
Plugging completed. February 9, 1949 19  
Reason for abandonment of well or producing formation

NORTH

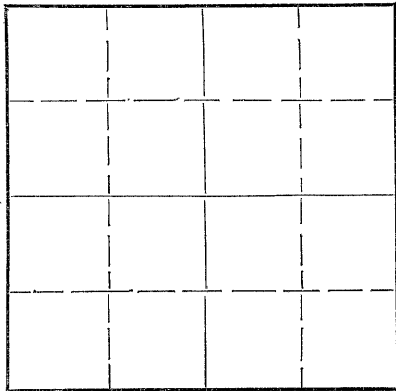

Locate well correctly on above  
Section Plat

Name of Conservation Agent who supervised plugging of this well. M. A. Rives  
Producing formation. Depth to top. Bottom. Total Depth of Well 3126 Feet  
Show depth and thickness of all water, oil and gas formations.

OIL, GAS OR WATER RECORDS

CASING RECORD

Formation	Content	From	To	Size	Put In	Pulled Out
Surface		0	150	8 5/8"	150	none
Lansing			3112	5 1/2"	3112	1379 feet

Describe in detail the manner in which the well was plugged, indicating where the mud fluid was placed and the method or methods used in introducing it into the hole. If cement or other plugs were used, state the character of same and depth placed, from \_\_\_\_\_ feet to \_\_\_\_\_ feet for each plug set.

Filled hole from bottom to 150 feet with heavy mud and bridged solid  
Run 15 sacks cement from 150 feet to 120 feet  
Filled with heavy mud from 120 feet to 20 feet  
Capped with 10 sacks cement from 20 feet to cellar

RECEIVED  
CONSERVATION DIV.  
FEB 28 1949  
STATE CORPORATION  
COMMISSION  
KANSAS

2-28-49

(If additional description is necessary, use BACK of this sheet)

Correspondence regarding this well should be addressed to Westgate-Greenland Oil Company, c/o G. E. Bitler  
Address. 1022 Union National Bank Building, Wichita 2, Kansas

STATE OF Kansas, COUNTY OF Sedgwick, ss.  
G. E. Bitler (employee of owner) or (owner or operator) of the above-described well,

being first duly sworn on oath, says: That I have knowledge of the facts, statements, and matters herein contained and the log of the above-described well as filed and that the same are true and correct. So help me God.

(Signature) G. E. Bitler

1022 Union National Bank Building, Wichita 2, Ks  
(Address)

SUBSCRIBED AND SWORN to before me this 26th day of February, 19 49


Esther Russell

Notary Public.

My commission expires May 25, 1949

22-2625

2-48-15

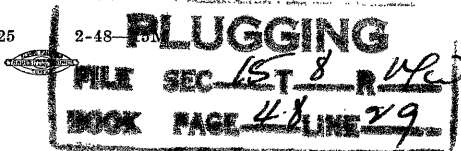

COMPANY: Westgate Greenland Oil Company  
 CONTRACTOR: Jackson Drilling Corporation  
 FARM: Spears #1  
 LOCATION: NW SW SE Section 15-8-14  
 Osborne County, Kansas  
 COMMENCED: May 22, 1948  
 COMPLETED: June 2, 1948 Rotary  
 August 7, 1948 Cardwell

0	to	40	Surface lime
40	to	690	Lime and shale
690	to	725	Sand
725	to	1065	Red bed
1065	to	1100	Anhydrite
1100	to	1140	Anhydrite
1140	to	1350	Lime & shale
1350	to	1880	Shale & shells
1880	to	1990	Shale & lime
1990	to	2185	Lime
2185	to	3055	Lime & shale
3055	to	3090	Shale
3090	to	3107	Lime
3107	to	3121	Shale & lime
3121	to	3126	Lime
		3126	T. D.

Set 150 ft. 8 5/8" surface casing. Cemented with 125 sacks cement.

Set 5 1/2" 14# casing @ 3112. Cemented with 60 sacks cement.

Top: Lansing - 3092

Perforated 96 shots 3112-24'  
 " 126 " 3094-3114'

500 gallon acid-show oil  
 3000 gallon acid-show oil.

2-28-49  
**RECEIVED**  
 Conservation Div.  
 FEB 28 1949  
 STATE INFORMATION  
 COMMISSION  
 KANSAS

C E R T I F I C A T E

I, Clare A. Stewart, do hereby certify that the above and foregoing is a true and correct copy of log of the Spears #1, Section 15-8-14, Osborne County, Kansas, as reflected by files of the Jackson Drilling Corporation.

*Clare A. Stewart*  
 Clare A. Stewart

Subscribed and sworn to before me, a Notary Public, within and for Johnson County, Kansas, this 13th day of August, 1948

*Dorothy J. Wilson*  
 Dorothy J. Wilson

My Commission expires November 30, 1950

**PLUGGING**  
 FILE SEC 15-8-14  
 BOOK PAGE 48 LINE 29