

15-141-30009-00-01

9-23-74


STATE OF KANSAS
STATE CORPORATION COMMISSION

RECEIVED Form CP-4
STATE CORPORATION COMMISSION
SEP 23 1974

WELL PLUGGING RECORD

Give All Information Completely
Make Required Affidavit
Mail or Deliver Report to:
Conservation Division
State Corporation Commission
212 No. Market
Wichita, Kansas 67202

Osborne County, Sec. 15 Twp. 8 N. R. 14 W. (E 1/4)
Location as "NE/CNW/SW" or footage from lines. C NE SW Wichita, Kansas
Lease Owner Petroleum Management, Inc.
Lease Name Spears Well No. 1
Office Address Box 1325, Great Bend, Ks. 67530
Character of Well (completed as Oil, Gas or Dry Hole)
Date well completed 19
Application for plugging filed 1-21 1974
Application for plugging approved 1-28 1974
Plugging commenced 4-1 1974
Plugging completed 4-1 1974
Reason for abandonment of well or producing formation

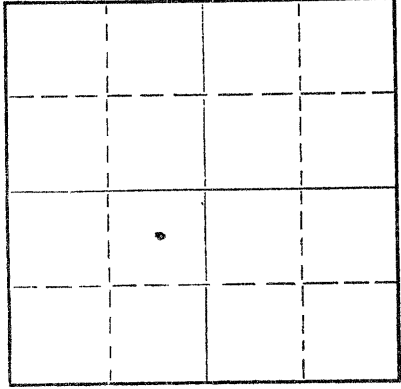

Locate well correctly on above Section Plat

If a producing well is abandoned, date of last production 19
Was permission obtained from the Conservation Division or its agents before plugging was commenced? Yes

Name of Conservation Agent who supervised plugging of this well Donald Truan
Producing formation _____ Depth to top _____ Bottom _____ Total Depth of Well 2975 Feet
Show depth and thickness of all water, oil and gas formations.

OIL, GAS OR WATER RECORDS

CASING RECORD

FORMATION	CONTENT	FROM	TO	SIZE	PUT IN	PULLED OUT
				10 3/4"	289'	
				4 1/2"	2933'	744'

Describe in detail the manner in which the well was plugged, indicating where the mud fluid was placed and the method or methods used in introducing it into the hole. If cement or other plugs were used, state the character of same and depth placed, from _____ feet to _____ feet for each plug set.

Plugged back with sand from TD to 2500'. Mixed and dumped 5 sx cement with dump bailer.

Squeezed down hole with 20 sx gel and 100 sx cement. Cement from 290' to top of surface pipe.

Plugged by Howco.

(If additional description is necessary, use BACK of this sheet)


Name of Plugging Contractor Midway Drilling, Inc. Cert. # 620
Address Box 921, Great Bend, Kansas 67530

STATE OF KANSAS, COUNTY OF SEDGWICK, ss.
DALE SILCOTT (employee of owner) or (owner or operator) of the above-described well, being first duly sworn on oath, says: That I have knowledge of the facts, statements, and matters herein contained and the log of the above-described well as filed and that the same are true and correct. So help me God.

(Signature) Dale Silcott

(Address)

SUBSCRIBED AND SWORN to before me this 20th day of September, 1974

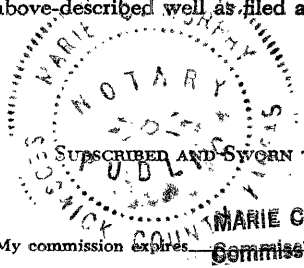

MARIE C. MURPHY, Notary Public
My commission expires April 23, 1978

(Signature) Marie C. Murphy
Notary Public.