

15-141-00036-00-00

STATE OF KANSAS
STATE CORPORATION COMMISSION


WELL PLUGGING RECORD

Give All Information Completely
Make Required Affidavit
Mail or Deliver Report to:
Conservation Division
State Corporation Commission
800 Bittling Building
Wichita, Kansas

Osborne County, Sec. 23 Twp. 8 S Rge. 14 (E) W. (W)

Location as "NE/CNW $\frac{1}{4}$ SW $\frac{1}{4}$ " or footage from lines C-NW-NW-SE
Lease Owner TEXAS PACIFIC COAL AND OIL COMPANY
Lease Name Nellie A. LaRosh Well No. 1
Office Address P. O. Box 2110, Fort Worth 1, Texas
Character of Well (completed as Oil, Gas or Dry Hole) Dry Hole
Date well completed February 22, 19 54
Application for plugging filed February 22, - Confirming 19 54
Application for plugging approved February 21, 19 54
Plugging commenced February 21, 19 54
Plugging completed February 22, - 3:30 A.M. 19 54
Reason for abandonment of well or producing formation

NORTH

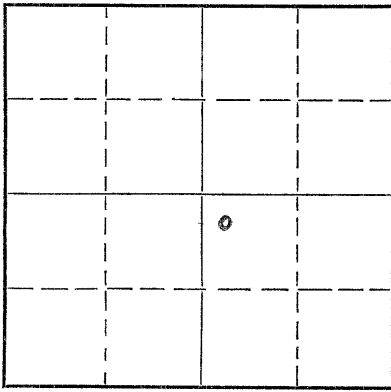

Locate well correctly on above
Section Plat

If a producing well is abandoned, date of last production 19
Was permission obtained from the Conservation Division or its agents before plugging was commenced? Yes-oral

Name of Conservation Agent who supervised plugging of this well
Producing formation None Depth to top Bottom Total Depth of Well 3740 Feet
Show depth and thickness of all water, oil and gas formations.

OIL, GAS OR WATER RECORDS

CASING RECORD

Formation	Content	From	To	Size	Put In	Pulled Out
None				10-3/4"	213	None

Describe in detail the manner in which the well was plugged, indicating where the mud fluid was placed and the method or methods used in introducing it into the hole. If cement or other plugs were used, state the character of same and depth placed, from feet to feet for each plug set.

Filled hole full heavy mud with 20 sack cement
plug at 160-200'; 10 sack cement plug 0-20'

2-24-54

(If additional description is necessary, use BACK of this sheet)

Correspondence regarding this well should be addressed to TEXAS PACIFIC COAL AND OIL COMPANY
Address P. O. Box 2110, Fort Worth 1, Texas

STATE OF TEXAS, COUNTY OF TARRANT, ss.
J. R. Teague (employee of owner or (owner or operator) of the above-described well,
being first duly sworn on oath, says: That I have knowledge of the facts, statements, and matters herein contained and the log of the above-described well as filed and that the same are true and correct. So help me God.


(Signature) J. R. Teague Manager of Production
P. O. Box 2110, Fort Worth 1, Texas
(Address)

SUBSCRIBED AND SWORN to before me this 22 day of February 19 54

Ruth Barfield
Ruth Barfield Notary Public.

My commission expires 6-1-55

23-3273-s 4-50-10M

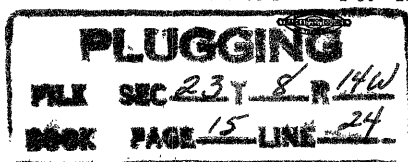

15-141-00036-00-00

COMPANY: Texas Pacific Coal and Oil Company
Lease: Nellie A. LaRosh
Field: Wildcat
County: Osborne
State : Kansas
Drilling Commenced: February 6, 1954
Drilling Completed: February 22, 1954

Well No. 1
Section 23, Township 8, Range 14-W
C-NW-NW-SE

Initial Production: Dry Hole
Casing Record: 213' 10-3/4" O.D., 32.75#

LOG OF WELL

	<u>TOP</u>	<u>BOTTOM</u>
Surface clay and blue shale	0	216
Shale	216	400
Sand and shells	400	445
Shale, w/strings of sand	445	575
Sand	575	595
Very hard gray shale	595	687
Shale	687	875
Redbed, clay	875	945
Anhydrite	945	1,034
Shale and shells	1,034	1,586
Shale, w/lime stringers	1,586	1,630
Shale, shells	1,630	1,693
Shale	1,693	1,820
Lime and shale	1,820	3,364
Lime and red shale	3,364	3,740

TOTAL DEPTH - 3,740'

2-24-54

