

15-141-20021-00-00

STATE OF KANSAS  
STATE CORPORATION COMMISSION


Form CP-4

Give All Information Completely  
Make Required Affidavit  
Mail or Deliver Report to:  
Conservation Division  
State Corporation Commission  
212 No. Market  
Wichita, Kansas 67202

WELL PLUGGING RECORD

Osborne County, Sec. 23 Twp. 8 Rge. (E) 18 (W) 14W

Location as "NE/CNW/SW" or footage from lines SW NW NW  
Lease Owner Petroleum Management, Inc.  
Lease Name Guyer Well No. 2  
Office Address Box 1325, Great Bend, Kansas 67530  
Character of Well (completed as Oil, Gas or Dry Hole)  
Date well completed 19  
Application for plugging filed 19  
Application for plugging approved 3-4 19 74  
Plugging commenced 4-1 19 74  
Plugging completed 4-1 19 74  
Reason for abandonment of well or producing formation

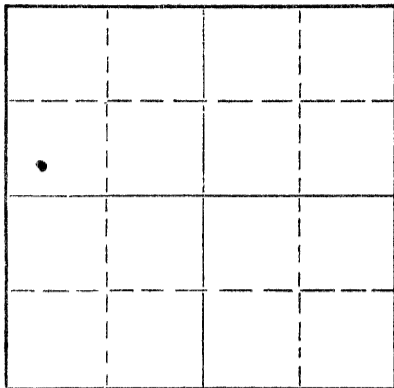

Locate well correctly on above  
Section Plat

If a producing well is abandoned, date of last production 19  
Was permission obtained from the Conservation Division or its agents before plugging was commenced? Yes

Name of Conservation Agent who supervised plugging of this well Donald Truan  
Producing formation Depth to top Bottom Total Depth of Well Feet  
Show depth and thickness of all water, oil and gas formations.

OIL, GAS OR WATER RECORDS

CASING RECORD

FORMATION	CONTENT	FROM	TO	SIZE	PUT IN	PULLED OUT
				8 5/8		
				4 1/2		639'

Describe in detail the manner in which the well was plugged, indicating where the mud fluid was placed and the method or methods used in introducing it into the hole. If cement or other plugs were used, state the character of same and depth placed, from feet to feet for each plug set.

Plugged back with sand from TD to 2500'. Dumped 5 sx cement with bailer.

Squeezed down hole with 20 sx gel and 100 sx cement.

Cement from 330' to top of surface pipe.

Pumped by Howco.

RECEIVED  
STATE CORPORATION COMMISSION

SEP 23 1974

CONSERVATION DIVISION  
Wichita, Kansas

9-23-74

(If additional description is necessary, use BACK of this sheet)

Name of Plugging Contractor Midway Drilling, Inc. # 620  
Address Box 921, Great Bend, Kansas 67530


STATE OF KANSAS, COUNTY OF SEDGWICK, ss.  
DALE SILCOTT

(employee of owner) or (owner or operator) of the above-described well, being first duly sworn on oath, says: That I have knowledge of the facts, statements, and matters herein contained and the log of the above-described well as filed and that the same are true and correct. So help me God.

(Signature) Dale Silcott

SUBSCRIBED AND SWORN TO before me this 20th day of September, 1974

My commission expires April 23, 1978

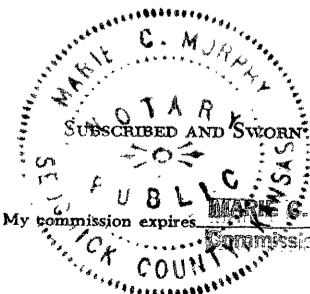

(Address) Notary Public.